

Section 32 Town 18

Range 4 West
5° 10' E


Survey by L M Koach Co Surveyor
of Jackson Co by direction of
Paul A Holden Surveyor of Monroe
County above

May 26. 27. 28th 29 ad 1903

Chairman

John Barnes
Aug Meekham

Dec 5° 03' East

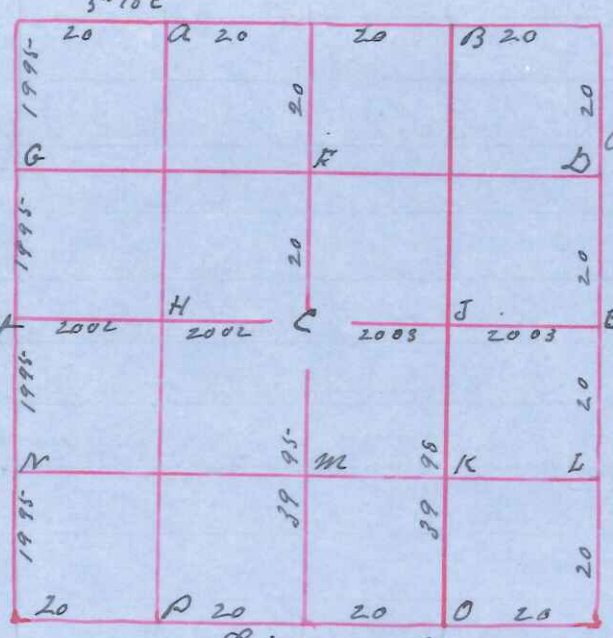

Field Notes

- Original NE Sec Corner New tree B 660 W 14
Orig B tree B 0 18 N 88 3/4 W 339
- " NW " " Old corner in Stone Pile identified by Stump
- " SW " " New tree No 6 N 48 1/2 E 22 Holden
- SE " " Set for distance from SW Corner and E 1/4 Post
- N 1/4 " " Stake 18 in south of Holdens Stake from Survey Sec 29
- S 1/4 " " New tree B 0 7 N 28 W 5-6 Holden
- Original E 1/4 " " B 0 18 S 2 W 741
- W 1/4 " " Jo 18 N 6 W 22 Holden

Subdivisions

- G Run 10 N 69 1/2 E 40
No 8 S 7 1/2 E 42
- A Stake
- B "
- H "
- I "
- J "
- K "
- L "
- M Iron pipe at corner
- N Jo 14 N 10 W 3 Holden
B 0 N 66 E 15 1/2
- O No 8 N 62 W 29
- P Stake

I hereby certify that the above diagram
and field notes are correct of the Partial
Survey of section 32 Town 18 Range 4 W
as surveyed by directions of J P Abel
and Paul A Holden

Dated this 1st day of June 1903

L M Koach

County Surveyor Jackson Co Wis

Recorded this 5th day Feb ad 1904

Paul A Holden
Co Surveyor