


Section 35 - town 17

Range 4 West

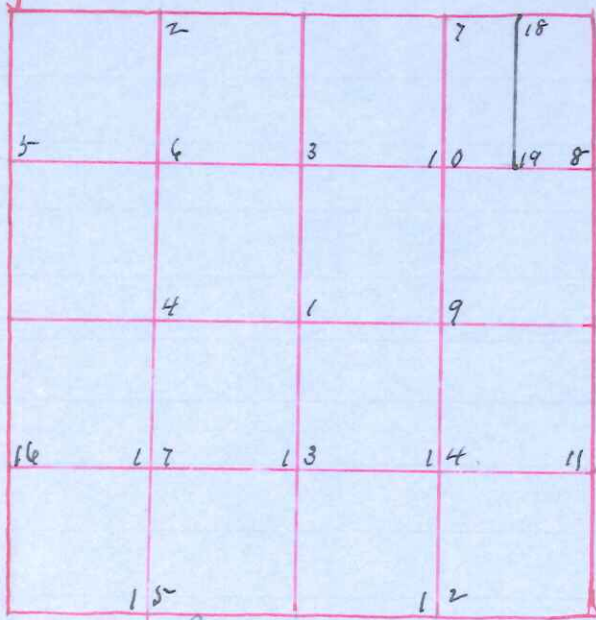

Sec 6° East

State of Wisconsin,  
County of Monroe J.S.S.  
I Fred A. Holder Surveyor in and  
for County and State aforesaid  
do certify that I have surveyed and  
subdivided the West 1/2 of Section 35 -  
town 17 Range 4 West done in accordance  
with State laws and the field notes of  
Original Supt Survey  
March 20th and 21st ad 1903

Field Notes

Original

NE Section corner 70 5 5 70 20 76 1/2  
Iron pipe at corner

SE " " Stake

N 1/4 " " Sandstone 6x6x12x 1/2

E 1/4 " " Dbl No 12 545-E 4

S 1/4 " " Stake

Subdivision

Sworn Assistants

# 1 No 5-N 45-E 46

Chairman

" 3 No 8 S 1 1/2 W 45 1/2

Jim Conully

" 8 1/2 in rod at corner

Harman Hahn

" 9 Stake at "

Shagman

" 10 70 5 5 73 1/2 E 23

August Hahn

" 11 1/2 in rod at corner

Carl Hahn

" 14 70 6 5 78 1/4 E 42

Alman

" 18 3/4 in pipe at corner

Bert Smith

" 19 Stake " "

Witness my hand this 10th day of August ad 1903

Fred A. Holder