


Section 2 & Town 17
Range 4 West

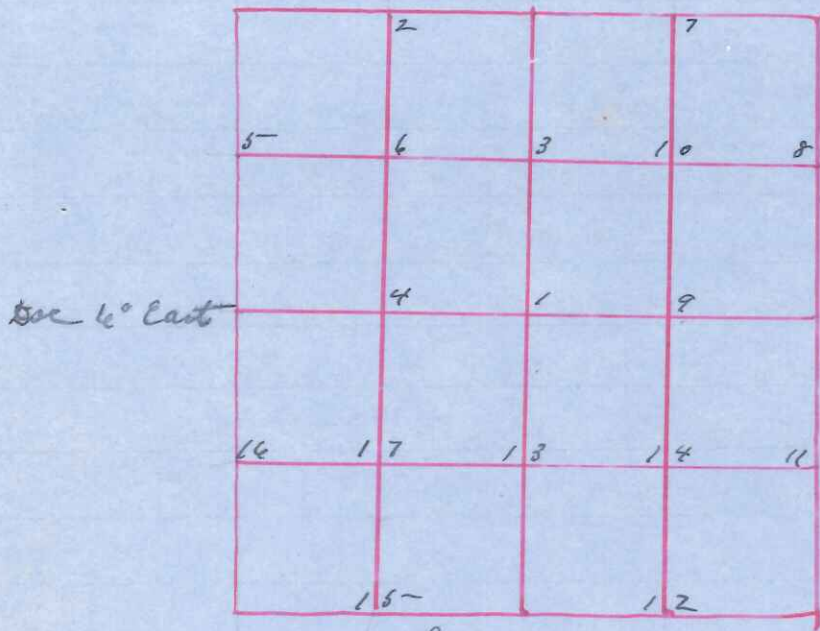

State of Wisconsin,
County of Monroe J.S.S
I Paul A Holden Surveyor in and
for County and State aforesaid do certify
that I have surveyed the SE 1/4 of Section
2 & Town 17 Range 4 West done in accordance
with State laws and the field notes of
Original Gout Survey
March 25th ad 1903.

- Original
- | | | |
|-------|-----------------|------------------------------|
| NE | Sections corner | Stake Center Highway |
| SE | " | " from pipe at corner |
| N 1/4 | " | " by chaining |
| E 1/4 | " | " Stamp O B hole |
| S 1/4 | " | " Stone + ink |
| | | " Red sandstone 6x6x12 x ink |
- Field notes
- | | | |
|-------------|--|------------------|
| Subdivision | | Sworn assistants |
| # 1 | 708 S 24 1/2 E 16
R 04 077 E 46 1/2 | Chairman |
| " 9 | R 0 12 089 1/2 W 114 | Jim Connelly |
| " 13 | R 0 4 030 E - 87 | Bert Schmitz |
| | | Flagman |

Witness my hand this 10th day of August a d 1903
Paul A Holden
Co Surveyor