


Sec 31 Town 16

Range 3 West

Sec 6° East

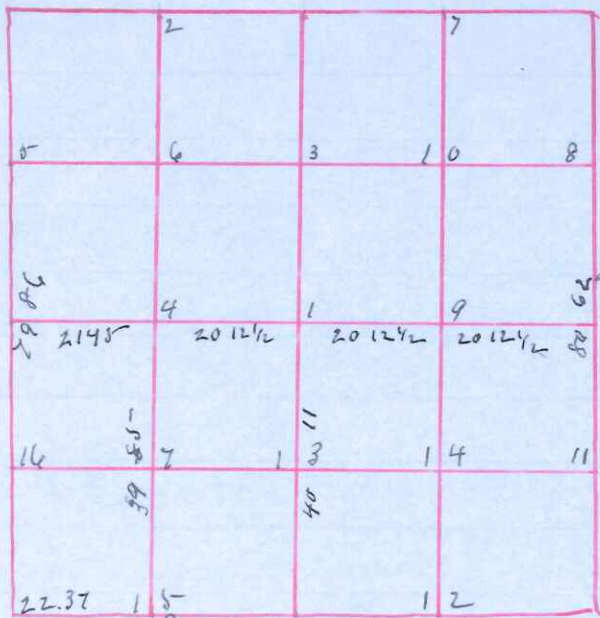

State of Wisconsin
 County of Monroe 1888
 I Paul A Holder Surveyor in County
 and State aforesaid do certify that I
 have surveyed and subdivided the S 1/2
 of sections 31 town 16 range 3 east done
 in accordance with State laws and
 The Field notes of Original East Survey
 April 13th + 14th ad 1903

Field notes

- Original NW Section Corner No 10 N 10 E 26
 " NE " " Iron at corner
 " SE " " Slight blow at cor
 " SW " " new pin fo 9 88 1/2 E 19 2 1/2 E
 Re-estab E 1/4 " " Bro 6 88 3/4 E 26
 " S 1/4 " " 2005-523 E 10
 " W 1/4 " " fo 6 N 86 E 5-
 " " " X in Sandstone ledge South 28

Subdivisions

- # 1 fo 10 S 87 1/2 W 45-
 " 4 No 7 South
 " 13 No 6 S 2 1/2 W 67 1/2
 " 15- Stake at corner
 " 16 No 8 S 1 W 15 1/2
 " 17 Stake at corner

Sworn Assistants

- Chairmen
 Oscar Olson
 Hans Everson
 Plagman
 Edwin Olson
 August Paulson
 Axmen
 Mike Olson

Witness my hand this 18th day of August ad 1903
 Paul A Holder
 Co Surveyor