


Sections 14 Town 16
Range 3 West

Sec 6' 30' East

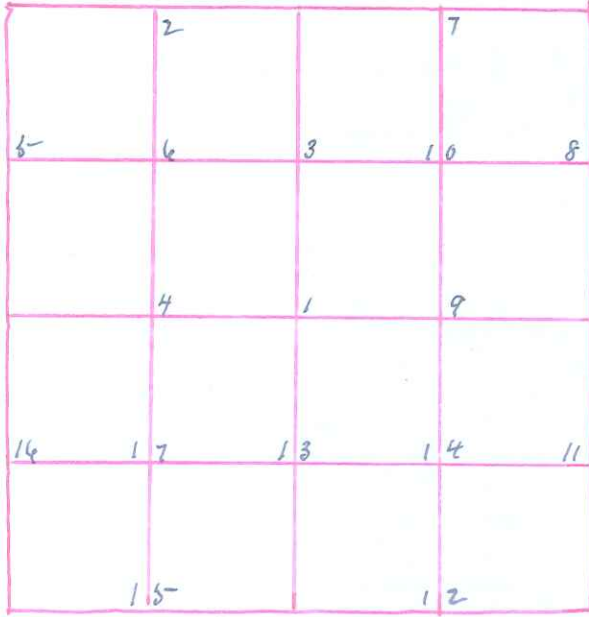

State of Wisconsin
County of Monroe J.S.S.
I Paul A. Holden Surveyor in and
for County and State aforesaid do certify
that I have surveyed and re-established
the East 1/2 of sections 14 Town 16
Range 3 West done in accordance
with state laws and the Field
Notes of Original Lost Survey
Nov 11th 1899 and April 22nd 1900

| | Field Notes | Stake (Larue) | # 3 No 12 N 1/2 W 5-2 |
|--------------|---|----------------------|-----------------------|
| Original | N E Section Corner | | |
| " | S E " " | No 12 N 47 1/2 W 108 | |
| " | S W " " | No 6 N 5-2 E 50 | |
| " | N 1/4 " " | No 12 S 2 1/4 W 101 | |
| " | E 1/4 " " | Stake Kenyon | |
| " | S 1/4 " " | Original | Sworn assistants |
| Subdivisions | " | Chainman | |
| # 1 | To S 1/2 E 32 " 7 S 65 1/2 E 57 " 4 S 60 E 90 1/2 | | John Flaig |
| " 7 | No 6 S 4 E 70 1/2 | | Guido Baumback |
| " 8 | Stake Kenyon | | Erving Kutzmann |
| " 9 | No 11 S 1/2 W 17 No 8 S 42 W 50 No 12 S 10 W 6 | | Walter Swartzlow |
| " 10 | No 10 N 37 W 19 No 6 N 80 E 42 | | Flagman |
| " 13 | No 8 N 10 E 103 No 6 N 16 E | | Jim Baumback |
| " 14 | " S 5 7 W | | Arman E Flaig |

Witness my hand this 6th day of Feb ad 1904
Paul A. Holden
Co Surveyor