


Section 30 town 19
Range 4 West

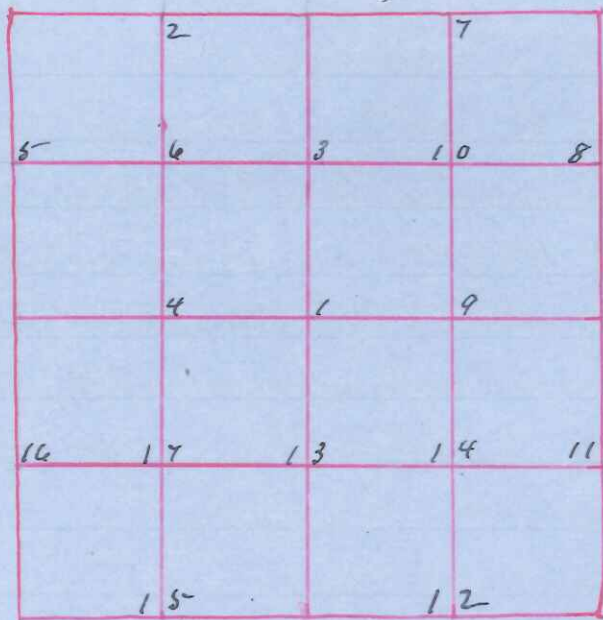

Sec 5° East

State of Wisconsin
County of Monroe S.S.
I find a Valid Survey in and
for County and State aforesaid do certify
that I have surveyed and subdivided
Section 30 town 19 Range 4 West
done in accordance with State laws
and the field notes of original Govt
Survey
Dec 1st 2nd & 3rd ad 1903

Field Notes

- Original NW Section corner Br 0 6845-10 5-2 3/4 Iron pin
- " NE " " Stake
- " SE " " New of Pine 6 S 36 1/2 W 59
- " SW " " New W 0 14 N 60 W 42 fo 18 S 65 E 122
- As Estab N 1/4 " " W 0 8 East 14
- " E 1/4 " " Br 0 18 N 6 W 134
- " 1900 S 1/4 " " Stake
- " W " " W 0 8 S 75 1/2 W 44
- Subd " "
- # 1 Stone at corner x m
- " 5- fo 10 West 42
- " 7 Br 0 10 N 68 W 87
- " 16 Stake

Sworn assistants
Chairman
Earl Smith
A. Abbott
Flagmen
Earl Smith
Clarence Harris
Arman
Herman Ronke

Witness my hand this 8th day of Feb ad 1904
Frank A. Halden
Co Surveyor