


S 1/2 Sec 17 - 17 - 3 W

Sec 5<sup>th</sup> E

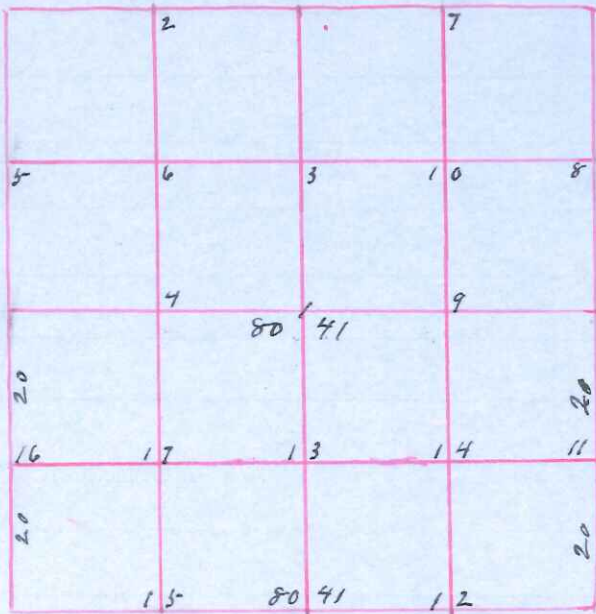

Field notes

State of Wisconsin }  
 County of Monroe } Paul A Holden  
 Surveyor in and for County & State of Wisconsin  
 do hereby certify that I have surveyed and  
 subdivided the South 1/2 of Section 17  
 Township 17 North range 3 West done  
 in accordance with State laws and  
 the Field notes of the Original <sup>Govt</sup> Survey  
 April 13<sup>th</sup> 14<sup>th</sup> & 16<sup>th</sup> ad 1904  
 by directions of Joseph Morrison

Re Established S E Sec Cor

do SW Sec Cor to 12 N 5 1/4 E 77 1/2 of Pine 8 N 37 1/4 E 45-

Original E 1/4 Sec Cor set Pipe from Slight shoe at corner to 12 N 68 E 244

Re Established S 1/4 " " set 2 in Pipe at corner

Original W 1/4 " " New B Line of Pine 7 S 60 W 5-

Subdivision corners

# 1 Piece Iron Slight shoe at corner (2 ft long)

# 4 Stake at corner

# 9 do

# 11 do

# 13 do

# 16 do

Sworn Assistants

Chairman

Flagman

Paul Holden

Paul Freeman

John Swanson

Charles Morrison

Paul Freeman

Frank Nichols

Attest Sam Woodliff

Witness my hand this 16<sup>th</sup> day of April ad 1904

Paul A Holden

Co Surveyor