


Office of County Surveyor  
 Monroe Co Wisconsin

Sec 22 town 15 N Range 1 East

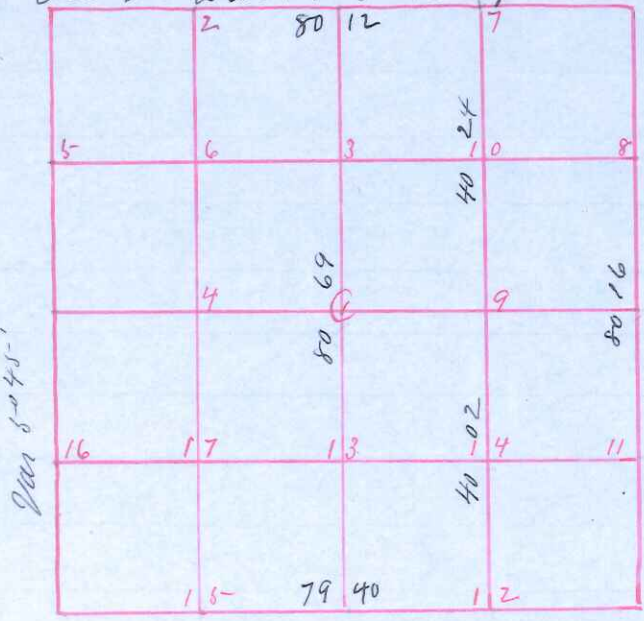

Survey made May 5+6<sup>th</sup> 1904  
 Lines run by fore and hind sights  
 All random stakes connected

- Sworn assistants  
 Chairman  
 Jm Walburg  
 L Ciesea  
 Playman  
 Otto Wolfgram  
 Bertie  
 Arner  
 Aug Wolfgram  
 Hugo

Field notes

- N E Sec Cor Reestablished by same from Piv. Center Highway
- N W Original Red 0 12 N 21° 20' 24" Stumps agreeing as to course + distance
- S W Stake set for distance from S E Corner at Old fence corner
- S E Original W 0 12 N 41 1/2 W 12 New Hickory 6 N 32 1/2 E 28 old stake called to vegetable field
- N 1/4 E + W fence North 27 lks 1905 Stone to be set
- S Reestablished in line set from at corner
- E " " " " " Piece from Sleigh shoe
- W not touched 1905 reestablished from Sleigh shoe at corner
- C Stone 6x6x24 + mark # 4 Stone
- # 8 drag tooth 12 in long # 5 from back of corner
- # 9 Sleigh shoe at corner # 6 Stake
- # 10 Iron batt 20 in long
- # 11 S set Stone + mk
- # 12 Iron at corner 2 1/2 x 3 x 24 Cog teeth on inside
- # 13 Stake at corner
- # 14 Stone " " + mk

I hereby Certify that the above diagram + field notes are  
 correct of a partial survey of Section 22 Town 15 N  
 Range one East as surveyed by direction of  
 August Wolfgram

Dated this 9<sup>th</sup> day May 1904

Jared A. Holden  
 Co Surveyor  
 Monroe Co Wis

N E 1/4, Surveyed Mar 27 or 28 1905  
 Chairman Alfred Howard  
 Alf Wolfgram Bert Otto Wolfgram  
 Grant Patten  
 Arner Lester Tompkins  
 C W