


8 1/2 Sec 31 town 15-N
R 1 East

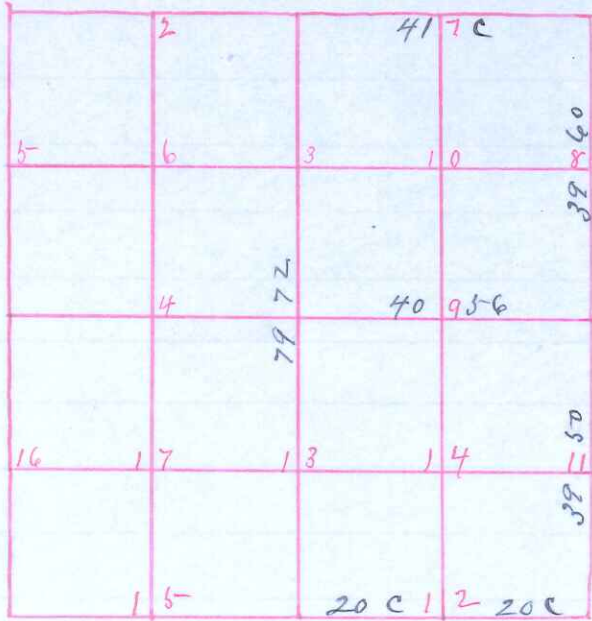

Office County Surveyor
Monroe County Wis
Survey Made June 14th + 15th 1904
Lines run by fore and hind sights
all random stakes corrected
Sworn Assistants

Chaimmen
George Buchanan
F. P. Puffhal
Hagonen
Lewis Jensen
James Jensen

Field Notes

- NE Sec Cor ^{wo st. N 22 E 18} S 47 E 51 remains plain New tree Sbl W 8 S 37 1/2 E 43 1/4
- NW Original
- SW " ^{These have been cut} by 4 Bearings Set drive Well Point
- SE " Maple 14 N 44 W 24
- N 1/4 ^{wo 6 S 62 W 4 1/4} Reestablished
- S Original ^{Redo 9 N 52 W 26 New tree maple 18 S 80 W 8} do 8 S 40 E 5 Set iron grate bar
- W not touched
- E Original ^{Redo 18 N 79 W 19} wo 28 N 22 E 36 Set piece from sleigh shoe
- C Set Piece from buggy axle 2 1/2 ft long
- #3 Set 3/4 in pipe at corner
- #8 " 5/8 in iron rod
- #10 ^{Hickory 14 S 15 1/2 W 20 202} iron rod at corner
- #11 Stone " hollow drilled in top
- #12 Cast Slate bar at corner
- #13 Set wagon skins at corner
- #14 " " " " " "

I here by Certify that the above diagram and Field notes
are correct of the Survey of the E 1/2 of Sec 31 Township
15 N Range one East as surveyed by direction
of James Jensen
dated this 6th day of Feb and 1905
Fred A. Holden
Co Surveyor
Monroe Co Wis