


Office Co Surveyor Monroe Co Wv

Sec 7 - 19 - 4 - W

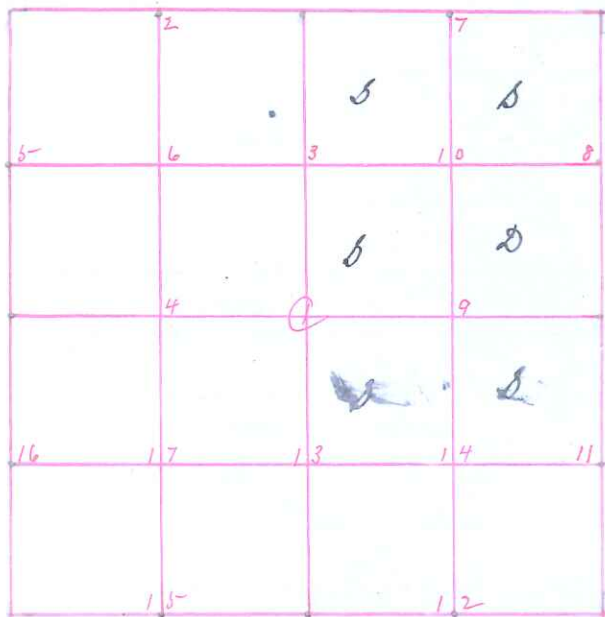

Survey made Aug 31st + Sept 1st 1904
 of NE 1/4. Post # 10 Established on strait
 line from Post # 9 to Post 7 and Equidistant
 from Each

Lines run by fore + backsights and all
 Random stakes corrected

Sworn assistants

Chairman

Charles Brown

Richard Krueger

Flagmen

Karl Stark

Wm Stark

Armen

Ed Geske

Frank Dero

Original

NE Sec Corner both O B then Standing

" N 1/4 " " in 1886 Corner by Krueger at that time

New tree to 12 N 57 E 68

E 1/4 Corner

Original

both old B then Standing

C1 Be 0 8 N 43 1/2 E 38
 do 9 S 16 3/4 E 143 1/2
 do 5 N 67 1/2 W 39 by Krueger 1886

3 all Stakes " " "

7 Be 12 S 18 E 77
 do 11 S 73 3/4 W 54 " " "

8 J Pine 6 S 49 1/2 E 27
 do 8 S 53 1/2 W 30 1/2 " " "

9 Be 0 8 S 39 1/2 E 118 " Holden 1904

10 Wo 16 S 57 1/2 W 11
 set Stakes at Corner " "

11 Be 7 N 34 1/2 W 43
 do 5 S 18 W 83 1/2 " Krueger 1886

13 Jo 6 N 23 1/2 E 25
 do 5 East 37

Chairman in Krueger work 1886 Karl Stark. Herman Parlow
 I hereby Certify that above diagram & field notes are correct
 of the Partial Survey of sections 7 Town 19 Range 4 West
 as surveyed by direction of Charles Stark
 dated this 13th day of September Ad 1904

Fred A Holders

Co Surveyor