


Sec 5 Town 17 R 1 East

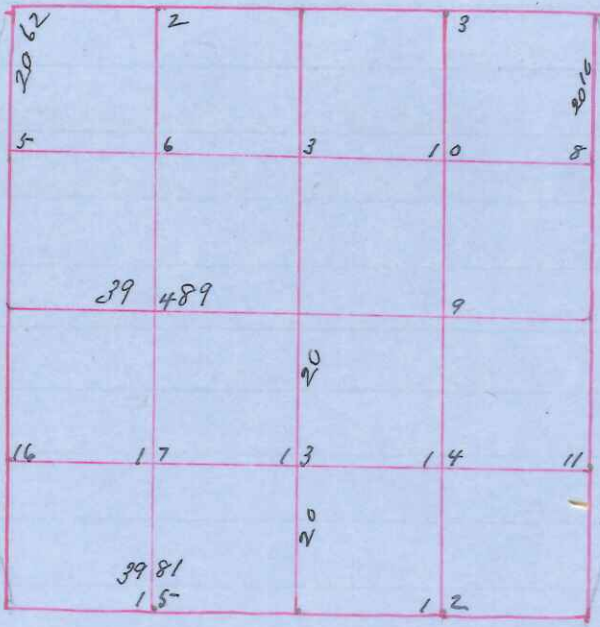

County Surveyor office
Monroe Co Wisconsin

Survey Made Dec 14-15-16+17 1904

Lines run by both fore and hind sights

All random stakes connected

Chainmen

W. H. Riley

Andrew Lauer

Flagmen

A. H. Lauer

Henry Mercer

Atmen

Samuel Mercer

Elie Mercer

NE Sec Corner Original Stps of 4 B trees set Stone + Mark

NW " " ReEstablished in Line from Pipe at Corner

SW " " " " from Pipe at Corner

N 1/4 corner " in Line 2 in from Pipe at Corner

S " " " 1 1/2 in Pipe at Corner

W " " " 1 1/2 in Pipe at Corner

Center " Angle from at Corner

2 1/4 from at corner

4 Stake at Corner

7 1/2 in Pipe at corner

13 1 1/2 in Pipe at corner

I hereby Certify that the above diagrams and field notes are correct of the Survey of the SW 1/4 of Sec 5 Town 17

Range one East as surveyed by directions of Lauer Bros

Dated this 6th day of February ad 1905

Freel A. Holden

County Surveyor

Monroe Co Wis