


Sec 6 town 17 R 1 E

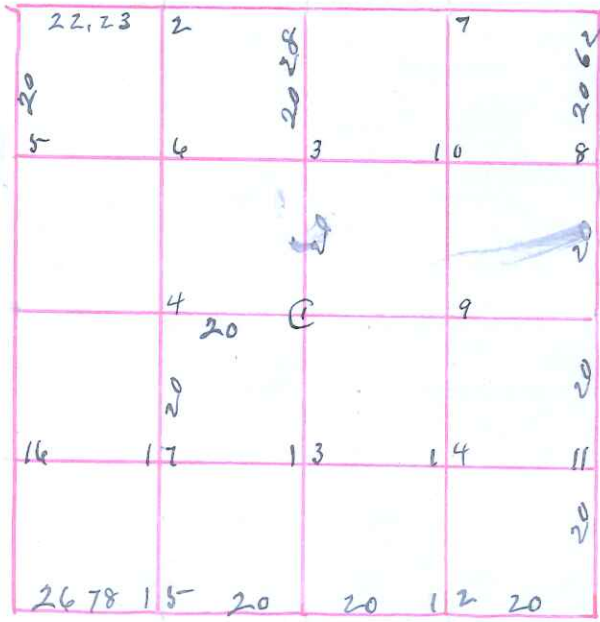

Office of County Surveyor
 Monro Co Wisconsin

Survey made Dec 14th 15, 16 & 17th 1904

all lines run by fore and back sights

all random stakes corrected

Chaimmen

W F Riley

Andrew Lauer

Flagmen

A H Lauer

Henry Mercer

Armen

Samuel Mercer

Ike Mercer

Field Notes

N E Sec Cor Reestablished from Pipe at corner

N W " " " in line on 4th Meridian from rod at cor

S E " " from Pipe at corner

S W " " Reestablished in line on 4th Meridian from Pipe at corner

N 1/4 1/4 in Pipe at corner

S 1/4 " to S N 67° 16' Pipe at corner

E Reestablished set Pipe at corner

Ⓟ from Pipe at corner

3 Stake at corner

4 Iron Pipe "

7 Stake

8 "

11 "

12 "

15 "

16 Iron pipe

17 "

I hereby Certify that the above diagram and field notes are correct of the Survey of Section 6 town 17

N Range one East as surveyed by directions of Lauer Bros

Dated this 6th day of February A.D. 1905-

Paul A. Holder

Co Surveyor Monro Co Wis