


Sec 9 town 17 R 4 W

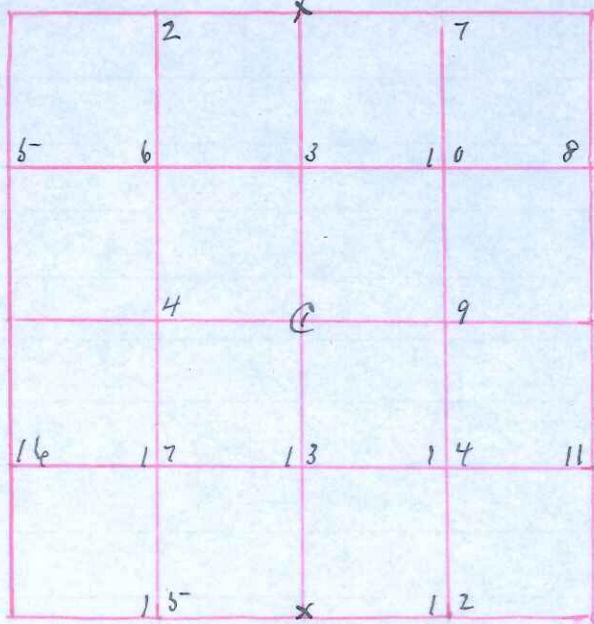

Survey to Establish N + S 1/4 Line  
 Made Oct 3rd 1904  
 Line run by both fore and back sights  
 all Random stakes Corrected  
 Chairman F. A. Holden  
 Amos Mann

Field Notes

- N 1/4 Original Stps of old B tree
- S 1/4 " " 1 old B tree still standing
- C Set 1 in square iron bar filled broken Stone around bar  
B 8 S 1° E 125'  
# 4 N 86 1/2 E 125'
- # 3 " " " " " through hole in Stone

I hereby Certify that the above diagram + Field notes are correct of the Survey above named as Surveyed by direction of S. J. Pinney  
 Paul A. Holden  
 Co Surveyor  
 Monroe Co Wis

Sec 32 - 2 19 R 3 W

Survey E + W 1/4 Line for Frank Baker and Henry Busse Made Sept 7th + 8th 1905

Chairman + Flagmen + Assessor

Henry Busse Frank Baker + F. A. Holden

N 1/4 Sec Corner Rail Sand Stone Pile North 8 ft

E 1/4 " " Keach

Center " " Stake + 2 in Iron Pipe

# 9 " " " " " "

Paul A. Holden  
 Co Surveyor