


S 1/2 Sec 32 Town 18 N R 1 E

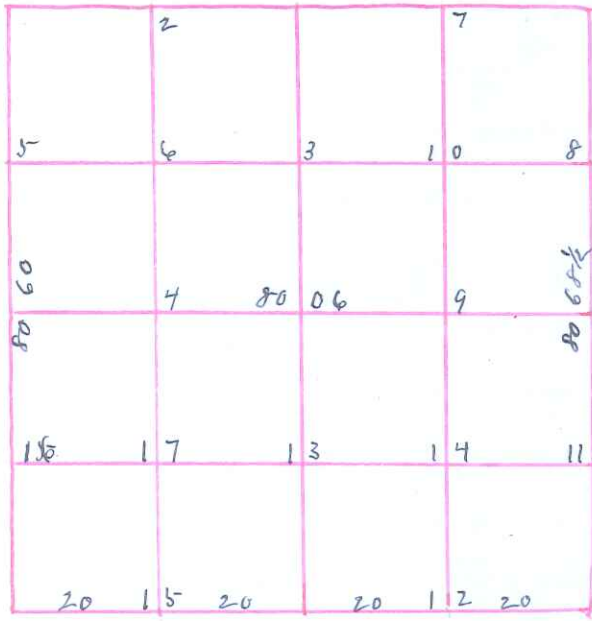

Office Co Surveyor
 Monroe Co Wis Survey made Dec 20th + 21 + 22 1905

all lines run by backs fore and back
 sights all random stakes corrected

Chairmen
 W J Riley
 Oliver Byard
 Flanagan
 Peter Olson
 Norman Herth
 Alman Ammund Olson

- Field Notes
- NE Sec Cor Stone + Mk at Corner
 - NW " " ReEstablished 1 1/2 in Iron bar at Corner
 - SW " " " Iron Pipe at Corner
 - SE " " Original Stps 4 B'hw Stone + Mk at Corner
 - N 1/4 " 1 1/2 in Iron at corner
 - S " " 2 in Pipe at corner
 - E " " Stone + Mk at Corner
 - W " " 2 1/2 in Pipe at corner
 - ① Sun vane " "
 - #3 Iron King ball " "
 - #4 Stone + Mk " "
 - #9 " " " "
 - #11 " " " "
 - #12 1 1/2 in Pipe " "
 - #13 2 " " " "
 - #14 Stone + Mk " "
 - #15 1 1/4 in Pipe " "
 - #16 1 in " " "
 - #17 Iron 3/8 in x 3 " "

I hereby Certify that the above diagrams and
 field notes are correct of above named survey as
 Surveyed by direction of Ammund Olson
 dated this 13th day of February ad 1905-

Paul A Holder
 Co Surveyor Monroe Co Wis