


NE 1/4 of SE 1/4 Sec 31 Town 18 N R 1 E

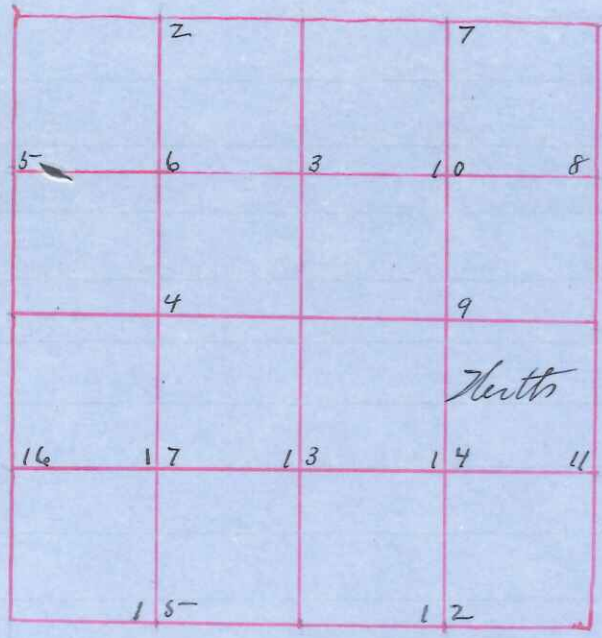

Office Co Surveyor
Mound Co Wis

Survey Made Dec 23rd 1904

All Lines run by face and back
Sights all standard stakes corrected
Chairman

W F Riley

Olliver Byard

Flagman

Peter Olson

Norman Herth

Build Notes

- NE Sec Corner Reestablished 1 1/2 in Iron at Corner
- NW " " Original. Stk old B tree known
- SW " " Reestablished in Line on 4th Meridian
- SE " " " Iron Pipe at Corner
- N 1/4 " " " Drive Well Pt at corner
- S " " " Iron at corner
- E " " " 2 1/2 in Pipe " "
- W " " " 2 1/2 in Pipe on 4th Meridian
- C " " " 1 in Iron Pipe at corner
- #9 " " " Iron 5/8 in x 1 3/4 in " "
- #11 " " " 1 in Iron Pipe " "
- #12 " " " 1 1/2 " " " "
- #14 " " " 1 " " " "

I hereby Certify that the above diagram and
Build Notes are correct of the above named Survey
as surveyed by direction of Norman Herth
dated this 13th day of Feb 1905-

Paul A Holder
Co Surveyor Mound Co Wis