


Sec 5 town 15-R 2 W

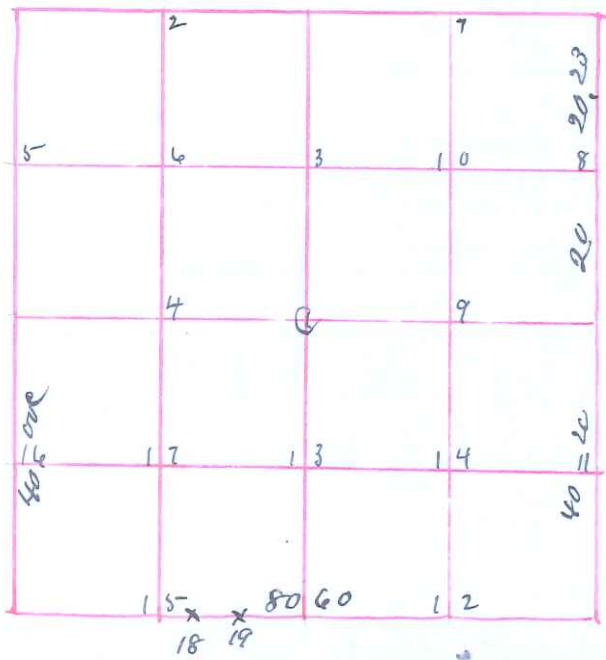

Office of Co Surveyor  
Monroe Co Wis

Survey Made June 7<sup>th</sup> 8<sup>th</sup> 9<sup>th</sup> + 10<sup>th</sup> 1904  
all lines run by both fore and back  
sights all random Stakes Cor  
rected

Chambers  
Arnold Schell  
Wm N Vieth  
Hagman  
Wm Vieth  
Otto Vieth

Field notes

old stake pt. Rotted  
to Reg. Mark

- NE Sec Cor Original Red 0 6 S 20 20 56  
do Stk 8 S 60 E 148 Set Stone 8x13x18 + on top
- SW " " Reestablished Br 0 4 N 42 1/2 E 7  
do 8 S 39 1/4 E 73 this agrees with Claim of  
Set Stone + Mk Remains of all 13 trees } all settled as to location of  
SE " " Original No 24 N 76 E 341 } old 13 tree
- N 1/4 " " " Remains both 13 trees and Stk pt  
" No 10 S 67 E 13 Set Stone + Mk
- S " " Reestablished No 4 N 82 W 34 2/3 from Stake at corner  
" " " Notice of old Bearings
- E " " Original Br 0 8 S 15 E 238  
" " " " " No 14 S 5 E 75 the only tree made
- W " " " " " No 10 S 44 1/2 E 20 66 1/2 Set Flint Stone 12x20x5
- # 3 Set Stone at Corner x Mk
- # 7 10 12 S 10 E 22
- # 8 Stake
- # 11 " "
- # 12 Iron "
- # 13 E 12 N 8 1/2 E 15  
Stone 16x18x5 + on top
- # 14 No 10 S 75 E 14  
Set Sand Stone + on top
- # 15 No 6 S 77 1/2 E 11 1/2  
Set 3/4 in Iron Pin 20 in Long
- # 16 No 6 N 70 20 25  
do 7 N 43 E 114 1/2 Set Flint Stone at corner
- # 17 No 6 S 87 E 54 1/2  
Set Stone x Mk
- # 18 26 Iron Pin 20 in x 3/4 in
- # 19 27 " " " " in Edge Marsh at Point Mark

I hereby Certify that the above diagrams  
and field notes are correct of the Partial  
Survey of Sec 5 town 15-R 2 West as surveyed  
by direction of Wm Vieth  
dated this 1<sup>st</sup> day of Feb 1905  
Luel A. Holder  
Co Surveyor