


Sec 8 Town 15-N Range 2 West

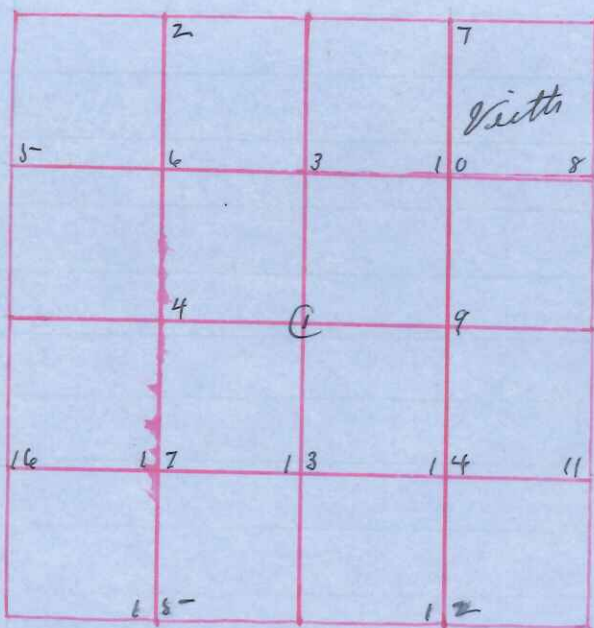

office to Surveyor  
Monroe Co Wis

Survey made Dec 6<sup>th</sup> & 7<sup>th</sup> ad 1804  
all Lines run by both fore and back  
sights all random stakes corrected  
Chairmen

Ben Wauk  
Theodore Vieth

Flagmen  
Wm Vieth  
Charles Vieth

Field Notes

- NE Sec Cor Original Remain old B tree No 24 N 76 E 341  
Set Stone at corner Cross MK
- NW " " Re Established No 4 N 42 1/2 E 7 this agrees with point  
do 8 S 39 1/4 E 73 when old B tree retained  
iron stake at corner to stand
- N 1/4 " " " " No 4 N 82 W 34 1/2
- S Original No 6 N 78 W 31  
do 8 S 28 E 20
- E " " old B tree Mark Plain
- # 2 No 6 S 77 1/2 E 11 1/2  
Set Iron Pins 20 in x 3/4 in
- # 7 Iron stake at corner
- # 8 No 16 N 70 1/2 E 33  
do 12 N 76 1/2 W 30 5/8 in Iron Rod 20 in long
- # 10 No 8 N 82 E 34 1/2  
do 6 N 25 1/2 E 34 Stone + MK at corner

I hereby certify that the above diagrams and  
field notes are correct of the Partial Survey  
of Sec 8 town 15-R 2W as Surveyed by  
direction of Wm Vieth

dated this 21<sup>st</sup> day of Feb 1906-  
Paul A. Hobler  
Co Sur