


Sec 4 Town 15-N Range 4 W 4th P M

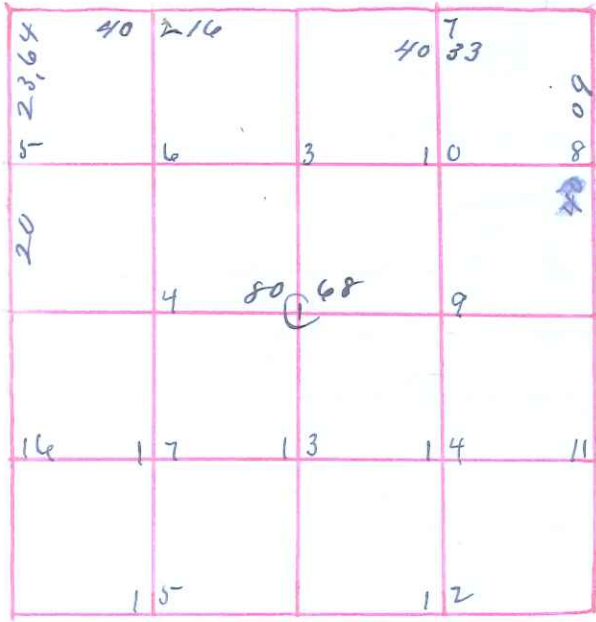

Survey made April 24th & 25th 1905
 Swork assistants

Chairmen

C. Jacobs
 John Flaig
 Lewis Erickson
 John Erickson
 Robt Oswald

Flagmen

Recorder

Sattfried Oswald

N E Sec Cor Original

Bo 10 N 7 1/2 E 390

Set Sandstone 12x12 in x 3 ft + Mk

N W Sec Cor Original

Wo 9 S 42 E 76

Other tree gone

N 1/4 Sec Cor Wo 10 Living Corner Original

Now Dead

E 1/4 Sec Cor Original

Wo 10 S 68 1/2 E 722

New tree Red 0 10 S 60 1/4 W 10 Set Stone + Mk at Corner

~~Center Stake~~

W 1/4 Sec Cor Stps both old & New Original

New tree Elm 12 S 88 1/2 E 64

Center #1 Stake

#5 Wo 12 S 13 1/2 E 43

#9 Stake

I hereby Certify that the above diagrams and
 Guild notes are correct of the Partial Survey of Sec 4
 Town 15 N Range 4 West as Surveyed by directions
 of Sattfried Oswald & C Jacobs
 dated this 26th day of April 1905

And A. Helder
 Surveyor Monroe Co Wis