


Sec 29 town 15 N Range 2 West 4th PM

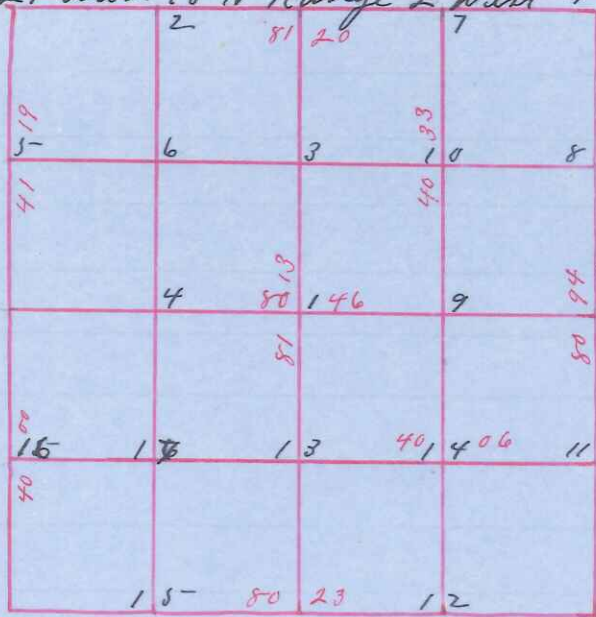

Survey made April 12, 13, 14 & 15 1905  
 under the provisions of and in strict con-  
 formity with Sections 827 a Statutes 1898  
 Laws 1901

Sworn assistants

Chairmen

A A Kinsbirk

S W Beckett

Flagmen

John Paull  
 Joe Curran

Witness Joseph Strait  
 John Curran

Field Notes

- N E Sec Cor 2 W 0 N 63 E 190 Original  
 Set stone at corner + mk on top  
 " 10 S 49 1/4 E 82 New
- N W " " 2 W 0 8 N 48 3/4 E 15 ReEstablished # 6 2 W 0 3 Square cap for corner  
 Set stone 8 ft x 12 x 8 in + notch # 7 2 W 0 6 S 11 E 46
- S W " " 2 W 0 8 S 56 W 95 Original Stone at corner + mk  
 Set stone 3 ft x 6 x 12 in + mk on top  
 2 W 0 8 S 3/4 E 35 New # 8 Elm 6 S 74 3/4 W 25-
- S. E " " Red 0 18 S 48 W 13 Original # 9 2 W 0 12 N 86 1/4 5-6  
 Set stone at corner + mk on top # 10 2 W 0 8 North 39
- N 1/4 " " 2 W 0 6 S 80 W 3 ReEstablished # 11 2 W 0 6 S 63 1/2 W 46 1/2  
 Set stone at corner + mk (Stone at corner + mk)  
 # 12 2 W 0 14 N 60 W 19
- S " " " Red 0 12 N 62 E 18 ReEstablished Stone at cor + mk
- E " " " 2 W 0 7 S 1 E 20 # 13 Stone at corner + mk  
 Set stone at cor + mk + mk on sand stone ledge N 19 W 56 1/2  
 " 12 N 60 1/4 E 17 # 14 Stone at cor + mk
- W " " " Red 0 8 S 63 E 65 Original # 15 " " " "  
 Set stone at corner + mk on top # 16 2 W 0 6 S 4 1/2 E 29  
 Red 0 5 N 45 E 2 New
- C Red 0 12 S 80 1/2 W 236 # 17 Stone at corner + mk  
 Stone of corner + mk
- # 2 Red 0 10 S 86 E 14
- # 3 2 W 0 5 S 76 1/2 W 23
- # 4 2 W 0 8 S 71 W 15 1/2  
 2 W 0 5 N 21 1/2 E 19 1/2

I hereby certify that the above dis-  
 grams and field notes are correct of  
 the survey of Sec 29 Town 15 N Range 2 W  
 as surveyed by directions of Joe Curran John  
 Mc Lains + others

Dated this 6th day of May 1905-

And A Holder  
 Geo Surveyor Monroe Co Wis