


Sec 28 T 15 R 1 W

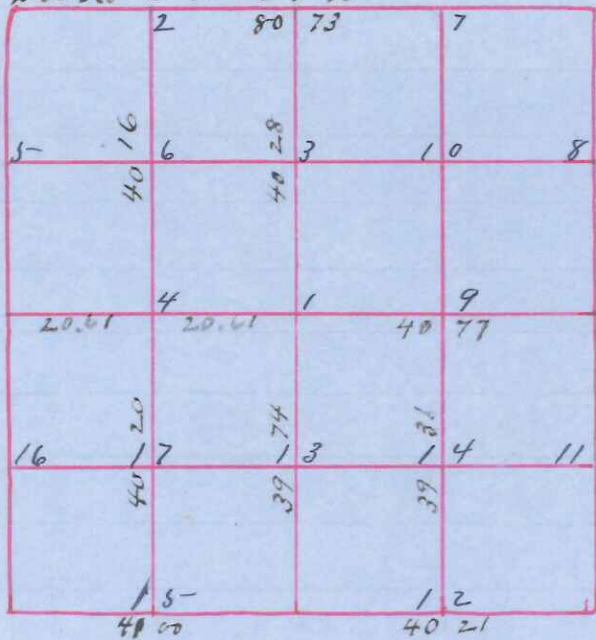

Survey made May 2nd 3rd + 4th ad 1906

Sworn assistants

Chairman

Charles Bucholtz

Flagmen

Frank Day

Eze Whitinger

Witness

D Whitinger

Field notes

- NW Sec Cor W ash 7 N 56 E 21 New Original by remains of old
 - W " 8 S 66 W 36 " Bearing + old stk pt
 - NE " " Sugar 12 S 89 E 32 Wash 11 S 27 W 29 (Re-established)
 - SE " " No 8 N 88 E ¹⁰¹ ~~101~~ ^{Ro 5 N 82 1/2 W 48} ~~Ro 5 N 82 1/2 W 48~~ "
 - SW " " 10 3 N 82 E 24 Blount + N 79 W 22 Original corner, old Brings + old Stake +
+ on sandstone ledge bear south 21 E 39 lks
 - N 1/4 " " Maple 18 S 22 1/2 W 5-8 re-established in line
 - E 1/4 " " Original corner by maple sth supported by affidavit herewith recorded
New Bearing Sugar 12 N 79 W 22
 - S 1/4 " " old Bearing Sugar 8 N 86 W 30 (Original) New Hickory 3 S 68 3/4 E 19
 - W 1/4 " " Original by Stone set when original Bearings established. New Iron State bar brick each
side N 47 E 38 1/2 Ash 18 S 26 W 38 State of Wisconsin
- #1 Hick 14 N 14 1/2 E 67 - Iron Sligh shov at corner
- #2 Elm 10 N 50 E 4
- #3 Sugar 8 S 43 W 17 1/2 Maple 6 S 30 E 25
- #4 Blount 20 S 71 W 60
- #5 W 3 N 37 W 20 1/2 W 4 S 78 E 6
- #6 Ash 8 Blount 4 N 3 1/2 W 38 1/2
- #7 Elm 24 S 45 E 61
- #8 Sugar 14 S 12 W 38 1/2 W 6 N 20 W 73
- #9 Bl 3 S 59 W 7 1/2
- #10 W 16 S 88 1/2 E 33 Ro 6 S 68 W 24
- #11 W 6 S 72 1/4 E 126
- #12 Red 12 N 35 1/2 E 53 Maple 4 N 28 W 22
- #13 Elm 10 N 31 E 22 Maple 10 S 81 1/4 E 15

County of Monroe } ss To Whom it

may concern We Calvin Day and Daniel
Whitinger do hereby make affidavit that
that a certain hard maple stump standing
near the 1/4 part between sections 27 + 28 Town
15 N range 1 West is the stump of one of the bearings
run for that corner named in the original

field notes that we have had intimate and continuous knowledge
thereof for many years and that some years ago the tree bore plain
marks that have since disappeared that this 3rd day of May 1906
we assisted the county surveyor Paul A Holden in setting corner stake
therefor and in making a new bearing for said corner
to wit Sugar 12 in N 79 W 22 L

D Whitinger

Calvin Day

Subscribed and sworn to before
me this 4th day of May ad 1906

Paul A Holden
County Surveyor