


Sec 27 T 19 R 2 W

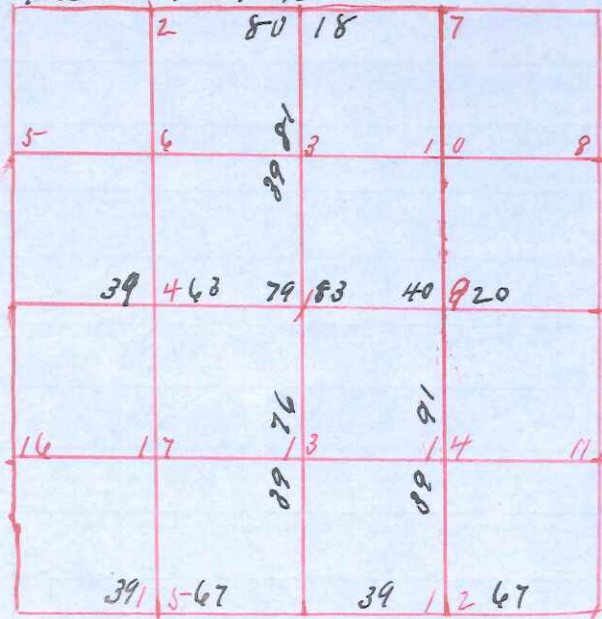

Survey made Nov 23<sup>rd</sup> to 25<sup>th</sup> 1906  
by direction of C M Moore  
Sworn Assitants

Chairmen

D M Sweeney  
C M Moore

Flagmen

Peter Hunt  
Martin Vanderwoot

all lines run by both fore and  
back sights all random stakes correct

Field Notes

- NE Sec Cor Norway Pine (Stk Lower Mark Plains) 10 S 13 E 23 Original
- NW " " Stks both of el B here Mkr plain Original
- SW " " 25 W Pine 12 S 18 00 E 36 "
- SE " " Root both old B here (original corner) New No 16 S 62 1/4 E 17
- N 1/4 " " Established in Line No 12 S 19 30' E 116
- S 1/4 " " B 0 8 N 22 W 69 Original
- E 1/4 " " Established by Kenyon
- W 1/4 " " W Pine 16 N 45 E 15 Original
- C1 B 0 12 N 63 1/2 E 25
- # 7 Stake
- # 9 J Pine 8 N 24 30' E 26
- # 10 Stake
- # 11 "
- # 12 Elm 20 S 16 E 139
- # 13 Stake
- # 14 "
- # 16 "
- # 17 "

Dated Dec 1<sup>st</sup> 1906

Paul A Holder

Co Surveyor