


S 1/2 Sec 16 Town 16 R 4 W

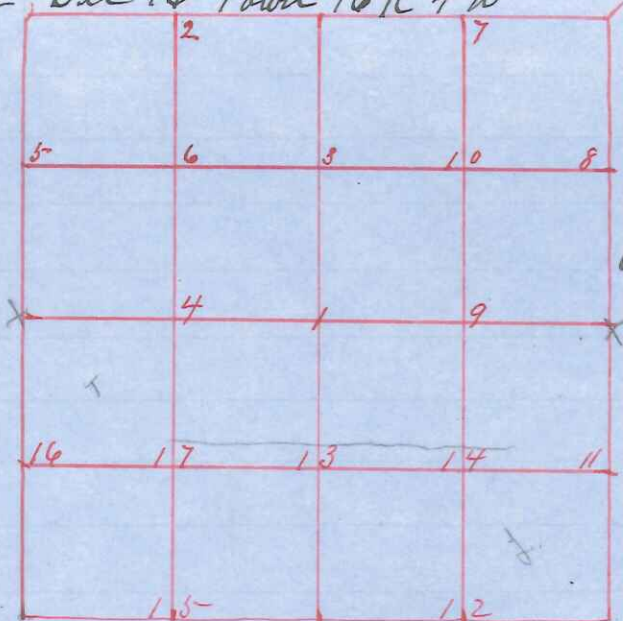

Survey made Nov 13, 14, 15th 1906
by direction of Wm J Jones

Chairmen

Wm J Jones
Anton Christiansen
Peter Larson

Flagmen

Ole Silbustson
George Gould

Lines run by both fore and back sights
all random stakes corrected

Field notes

SW Sec Cor	1 old B tree	Original
SE " "	" " "	"
E 1/4 "	B 20 12 N 39 W 98	"
N 1/4 "	Old Bearings	" New fo 14 S 65 E 30 1/2
# 11	B 20 6 N 45 W 4	
# 12	W 6 East 6 1/2	
# 13	R 10 6 S 69 1/2 E 25-	
	" " 8 S 21 W 19	
# 14	fo 8 N 15 W 5 1/2	
	" 9 S 15 W 15-	
# 16	B 20 20 N 80 E 48 1/2	
# 17	fo 7 N 8 E 12 1/2	

Dated Feb 25th 1907

Paul A Holden

Geo Surveyor