


Sec 17 T 16 S W

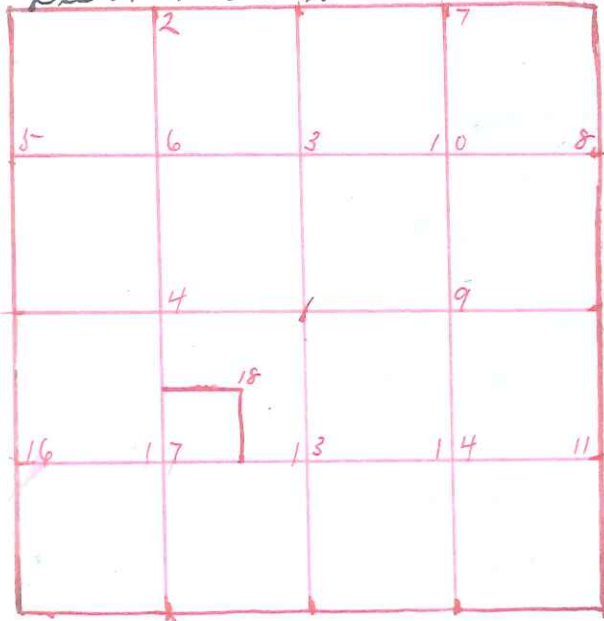

Partial  
Survey Made by directions of Aug Fisher  
Dec 26<sup>th</sup> + 27<sup>th</sup> 1906

Chairmen

Aug Fisher

Oscar Evenson

Flagmen

Simon Wells

John Nichols

Field Notes

- NW Sec Cor No 10 N 42 1/2 W 125 Original
- SW " " remains old bearings " New true Br 18 N 22 1/2 E 97
- SE " " Reestablished from N, S, E + W
- N 1/4 " " 1 old B true Original
- S 1/4 " " reestablished in line
- W 1/4 " " " " " No 16 N 85 E 38
- C1 by Lane 1898 No 15 S 42 W 96 1/2
- # 4 No 6 N 60 W 12
- # 13 No 10 N 21 W 103
- # 15 26 Br 10 N 47 E 26

Dated Feb 25-1907

Paul A Holden

Co Surveyor