


S 17 T 18 R 4 W

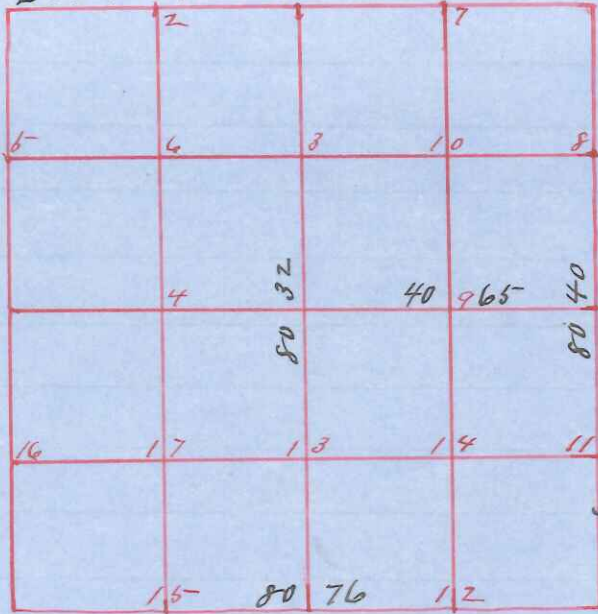

Survey made May 30th 31st & June 4th 1907
by direction of Robt Williams and Henry
Watte

Sworn assistants

Chairmen

Robt Williams
Paul Gaunke

Flagmen

Ed Yerke
Paul Blads

Witness

Henry Watte
Louis Pafk

Field Notes

- NE Sec Cor Original Corner by remain of old bearing (now fo 12 N 1° 15' W 315-)
- S 2 " " " Bearings
- SE " " reestablished fo 8 N 54 W 19 1/2 in pipe at corner
- N 1/4 " " No 12 S 13 W 94 Original
- No 7 N 44 W 29 " "
- S 1/4 " " reestablished in line fo 5 S 67 1/2 W 11
- E 1/4 " " Thick 12 N 86 1/2 W 55
- C 1 No 14 S 53 1/2 E 64 1/2 in pipe at corner
- #7 Cherry 12 South 14
- #8 No 8 S 2° W 19
- #9 No 4 S 5° W 9 1/2
- #11 Thick 5 N 72 1/2 W 65 1/4
- #12 No 16 N 20 E 52 1/4 in pipe at corner

Recorded this 5th day of June 1907

Paul A. Holder

by Surveyor