


S 26 T 15 R 20

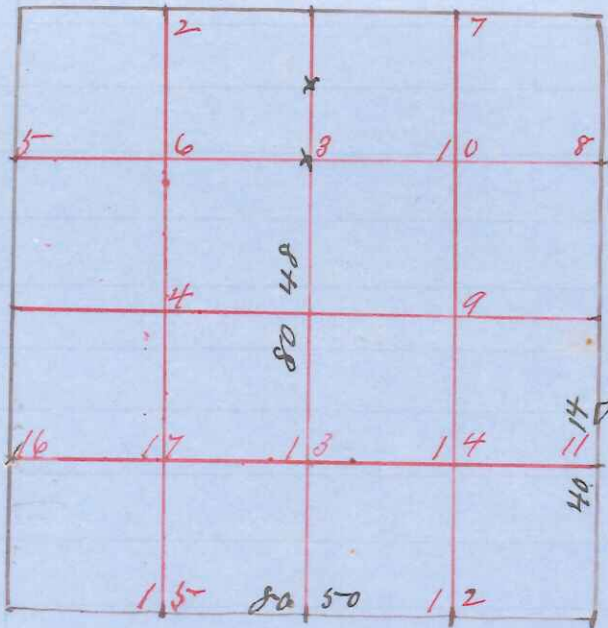

Survey made April 13, 14 & 15 1908
by direction of H.E. & F. le Bredlow

Sworn assistants

Chairmen

John Hutchinson
F. le Bredlow

Flagmen

H. E. Bredlow
Henry Bredlow

Recorder

John Bredlow

Field Notes

- S W Sec Cor established former Survey
- S E " " No 6 S 41 1/2 W 14 Original
- N 1/4 " " Pine Stump 28 S 10 E 8 Original Mark plain
- S 1/4 " " ~~No~~ established in line No 10 south S - No 6 S 77 E 39
- E 1/4 " " No Stump 8 S 68 W 30 Original
- # 3 " " Iron Stake at corner
- # 11 " " No 10 N 24 E 6-2
Maple 12 S 57 1/2 W 118 1/2
- # 13 " " No 8 S 83 1/2 E 59 1/2

Recorded April 20th 1908

Paul A. Holden

Co Surveyor