


Sic 1 T 15-R280

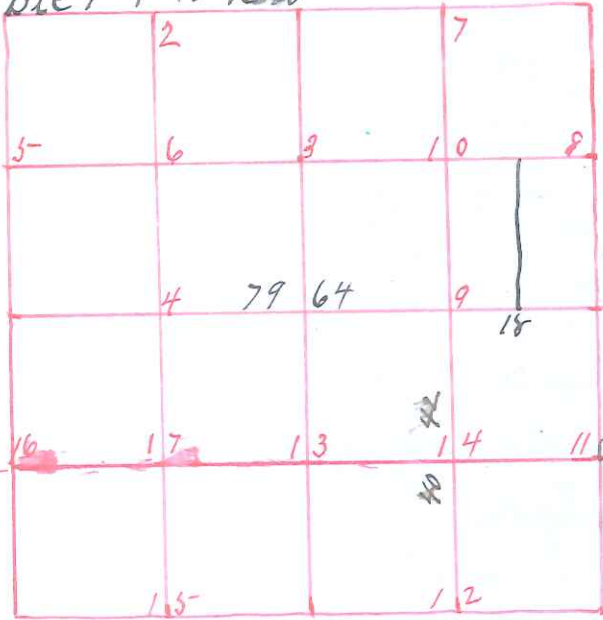

Survey made Feb 5-6th 1908
by direction of Frank Meyer
Sworn assistants

Chairman

Aug Rohde
George Daugherty

Flagmen

Ray Quinn
Frank Meyer

Field notes

NE Sec Cor
SW " "
SE " "
S 1/4 " "
E 1/4 " "
N 1/4 " "
C1
#9
#12
#14
#18

Original

"
" Stone at corner
" New tree Elev 18 S 1°30' W 26
" Stone at corner
" "
" Iron Pipe at corner Elev 10 S 34° E 21
" " " "
" Corner by Kenyon Chong 10 N 35 1/2 E 46
" Iron pipe at corner
" 26 Bro 10 N 38 1/2 W 38 Bro 10 S 35 1/2 W 26

Recorded this 1st day of March 1908
Fred R. Holden

Co Surveyor