


S1E 19 T 15 R 3 W

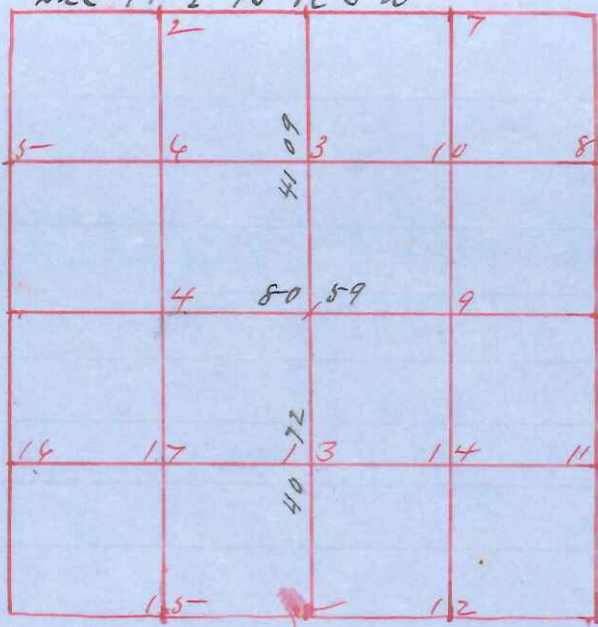

Survey made May 22+23 1907
by direction of O. L. Melgaard
Sworn assistants

Chairmen

O. L. Melgaard

H. Melgaard

Flagmen

Frank Schmier

Herbert Melgaard

Field notes

- | NE Sec Cor | Original Cor | Cor |
|-----------------------------------|--------------------------|----------------------------------|
| NW " " | " " | " " |
| SW " " | " " | " " |
| SE " " | " " | " " |
| N ¹ / ₄ " " | " " | " " |
| S ¹ / ₄ " " | No Stump 20 N 56 W 56 | Original No 14 S 35 E 15 1/2 new |
| E ¹ / ₄ " " | No 18 S 82 E 47 | " " |
| W ¹ / ₄ " " | No 14 S 34 W 40 Original | |
| | " 9 N 23 W 35 | " No 12 N 45 W 27 New |
| C 1 | fo 18 S 40 E 32 | |
| # 4 | No 5 S 56 W 33 1/2 | |
| # 13 | Stake. | |
| # 16 | fo 6 N 45 E 02 | |
| # 17 | + on rock N 45 E 04 | |

Recorded May 28th 1907

Paul A. Holden

Geo. Sawyer