


Sec 67 18 R 1 West

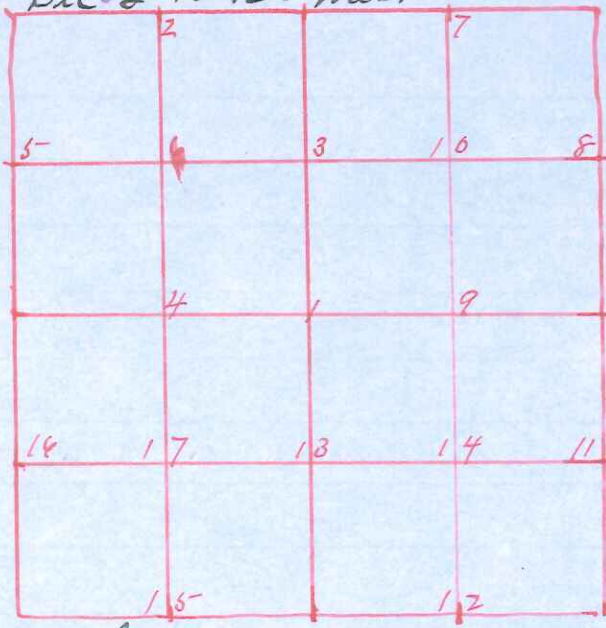

Survey made June 1st to 2nd 1908
by direction of J. J. Purdy
Survey Assistants

Chairmen

J. J. Purdy
Austin Sutton

Flagmen

Milo Purdy
Dell Purdy

Field Notes

- NW Sec Cor No 11 S 37 W 30 Original
- NE " " No 12 N 31 W 32 "
- NE " " Stone at Original Corner
- SE " " reestablished
- SW " " Maple 20 S 9 W 13 Original
- N 1/4 " " reestablished in Line
- E 1/4 " " " " Jo 8 N 14 E 81 No 4 S 50 E 99
- S 1/4 " " Stake
- W 1/4 " " 1 in pipe north 35 1/2
- C 1 Dragtooth south 28
- # 4 1 in iron pipe ^{south 33} at corner
- # 16 1 " " " Coupling on top at corner
- # 17 Dragtooth at corner

Recorded June 5th 1908

Paul A. Holden
Co Surveyor