


Sec 13 T 18 R 4 W

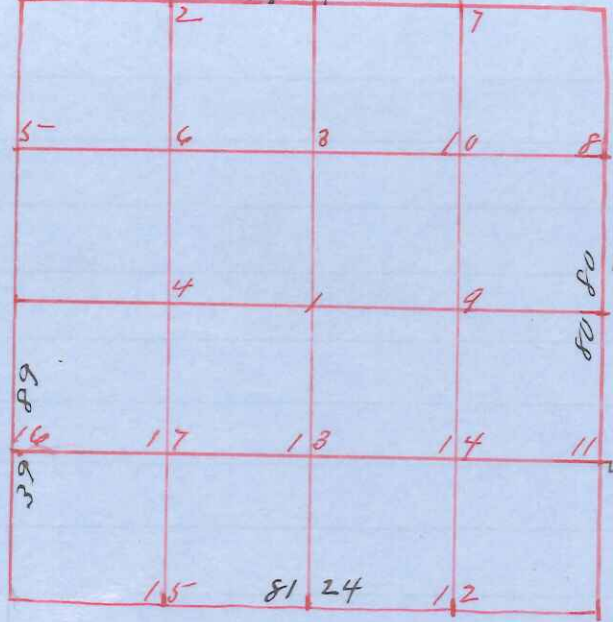

Survey Made June 25<sup>th</sup> 26<sup>th</sup> + 27<sup>th</sup> 1908  
by direction of Geo Starkey & Paul Benson  
Sworn Assistants

Chairmen  
Geo Starkey  
John Fitzsimmons  
Flagmen  
Paul Benson  
Page  
Roger

Field Notes

- NE Sec Cor Original Corner
- NW " " (1 old tree) to 4 N 70 E 14 New 1 1/2 in pipe at corner
- SW " " 2 bearings Stone at corner ✓
- SE " " New " Rod 0 8 South 100
- N 1/4 " " reestablished in line
- S 1/4 " " No 10 N 44 1/2 W 73
- N 1/4 " " Original old bearing new then No 4 N 72 W 5-2
- # 6 Stake
- # 7 "
- # 12 "
- # 13 "
- # 14 "
- # 15 No 14 S 7 1/4 W 73 1/2
- # 16 1 1/4 pipe at corner
- # 17 to 6 S 5 W 18

Recorded Feb 1st 1909  
Fred A Holden  
Co Surveyor