


Sec 11 Town 16 North Range 4 West

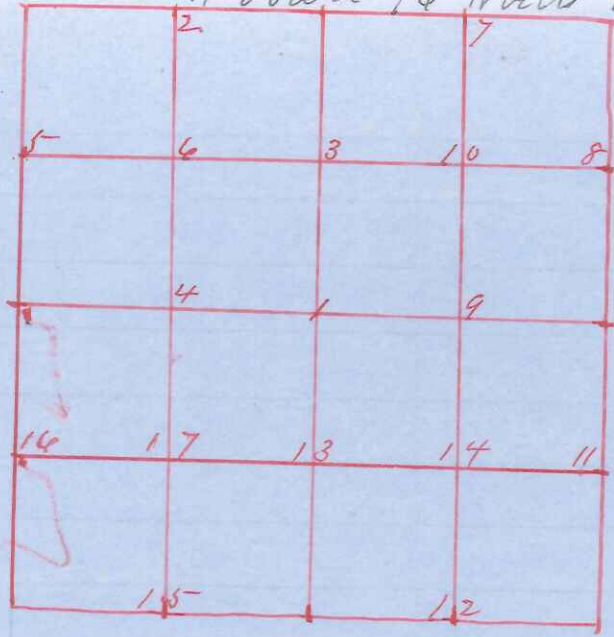

By Wm. Kenyon
 Chairman Sworn
 Robt Smith
 Geo A Chapman

Set for Post NW Corner RR Bar 12 in long
 Bm Bc D 10 S 68 1/2 E 152
 N Elm 8 S 52 1/2 W 68
 W 1/4 Set Post from Shaft 4 ft long Bot Elder 12 N 13 1/2 E 137
~~SE Corner Norway Spruce 8 N 21 E 148~~
~~W Maple 7 S 86 E 206 1/2~~
 NE Cor Lot 4 Blk 1 Part 1/8 Square from bar 2 1/2 ft long Per 11 1/2 in holes
 NE " Blk 2 Part 1/4 Square from bar 2 1/2 " " " 13 " " "
 SW " " 1 " 1/4 " " 2 1/2 " " " 12 " " "
 NW " " 1 " 1/4 x 5/8 " " 2 1/2 " " " 14 " " "
 Post 12 1/2 rods South of 1/4 line at NW Corner of Plot Bot Elder 12 N 88 1/4 W 11
 Set Post for future Survey at S W Cor of D M West's Acreage
 from Pipe 1 1/2 in x 2 1/2 ft long 32 links South of Carkeye Stake
 Set Post N W Corner of Village from bar 1 3/4 in x 5/8 in 2 1/2 feet long
 Perforated 13-1/2 in holes Norway Spruce 8 N 21 E 148 L
 W Maple S 86 E 206 1/2

I hereby Certify that the above diagram & field notes are
 correct of the Partial Survey of Secs 10 & 11 & Village of Leona
 Town 16 N Range 4 W as Surveyed by directions of E F Austin
 this 15th day of June A.D. 1885
 W Kenyon
 Co Surveyor

Recorded this 12th day of May A.D. 1908
 Paul A Holden
 Co Surveyor