


Sec 2 Town 19 N Range 4 W

Survey Made Oct 29th 1909

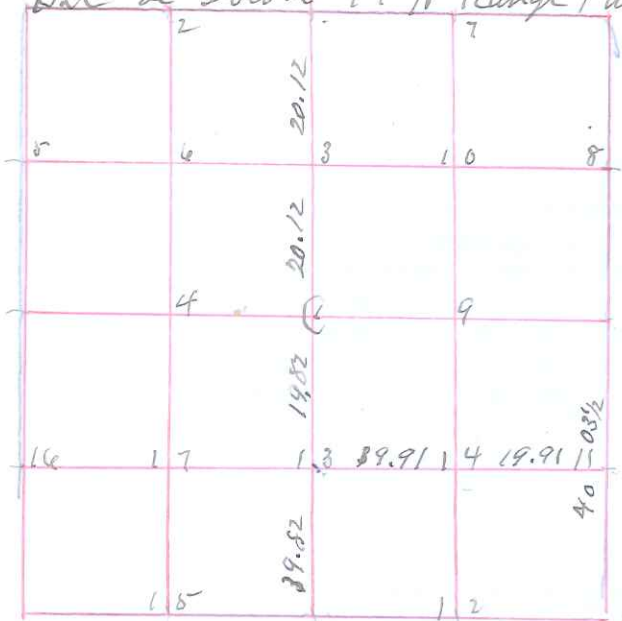

N E Sec Cor Not touched

N W " " " "

S W " " *Stops with 13 trees Stone pile at cor*

S E Reestablished as per rule Stone + mk

S 1/4 " " " "

N 1/4 Original by N W tree

E " "

W " "

C Stake at corner

3 " " "

11 " " "

13 " " "

14 " " "

I hereby Certify that the above diagrams and field notes are correct of the partial Survey of Sec 2 Town 19 N Range 4 W as Surveyed by direction of Aug Wittmichel dated October 29th ad 1909

Paul A Holder
 Surveyor Monroe Co Wis