


JEFFERSON AVE.

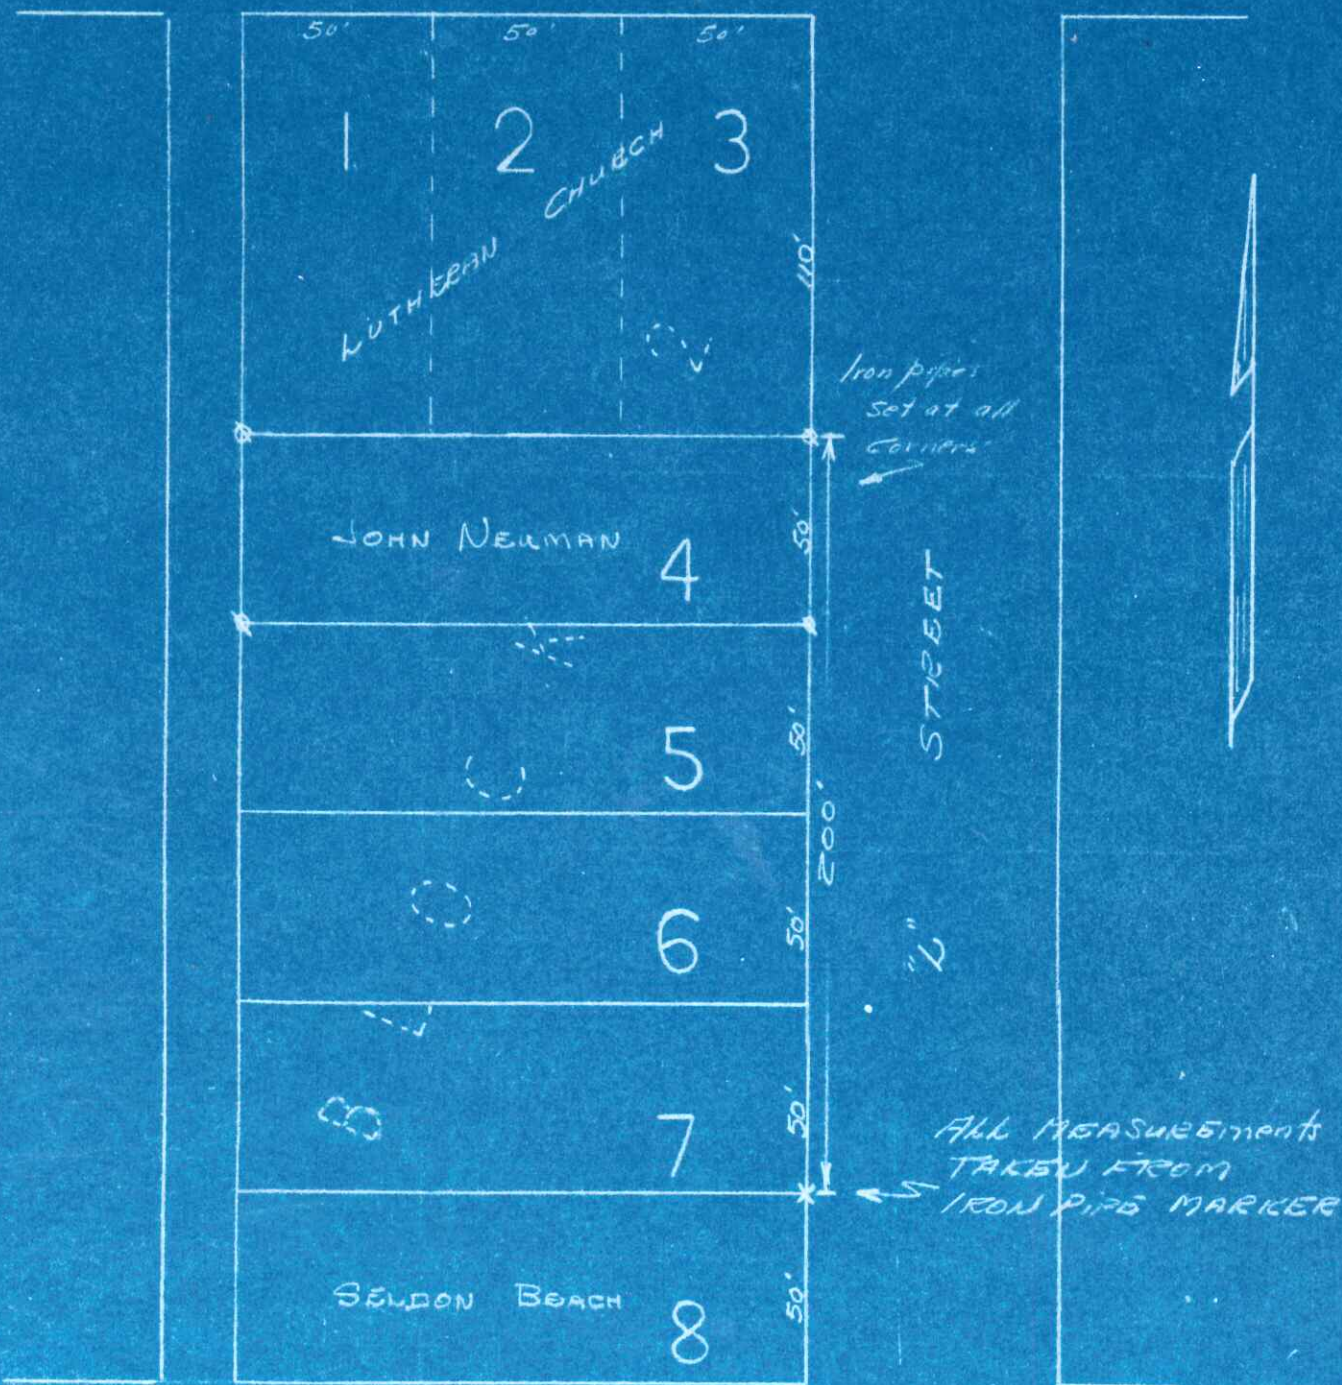

BLAKE ST.

BROOK'S AND WOOD'S ADD.

SURVEY OF JOHN NEUMAN Lot
8-21-45

By O. O. BEBEMAN -
SCALE 1" = 50'