


Survey & Subdivisions of  
 Section 35 Township 18 north Range 2 West of 4th principal  
 Meridian by direction of S S Hilliker Sr & others commenced

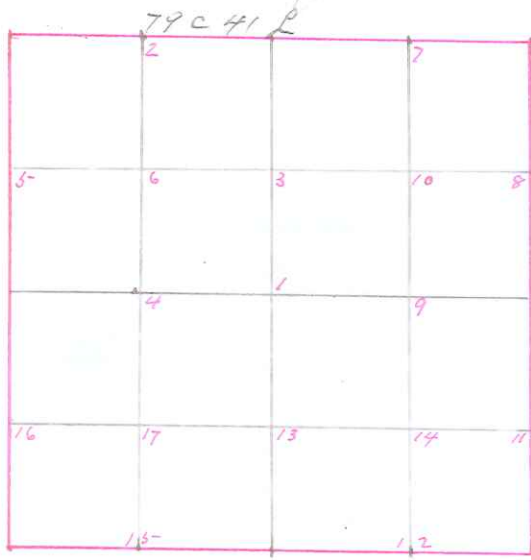

at 1/4 Post on south side section 36  
 a known corner running West to 1/4  
 Post south side 35 identified by one  
 Original B Tree standing to wit  
 No 20 - N 89 W - 192 Establishing S E Cor  
 of 35 Equidistant between, at 40 chains  
 from either thence West 80 chains at  
 a var 5° 30' Established S W Cor Section  
 a known corner thence North var 5° 40'

80 chains Establishing N W Corner thence East var 5° 30' 79 chains 41  
 Links to N E Corner Establishing 1/4 Posts Equidistant from section corners  
 & center of sections at intersections of straight lines through sections  
 from 1/4 posts subdividing 1/4 sections in same manner making  
 Bearing trees

Surveyed & subdivided  
 Jan 9th 10th & 11th ad  
 1901

- At S E Corner Section No 5 N 49 E 28 No 5 S 46 W 34
- " N 1/4 Post fo 8 N 70 E 38
- " # 2 fo 8 S 6 W 32 - fo 4 S 87 E 54
- " # 4 No 6 S 66 E 17 - No 8 N 20 W 24
- " # 5 No 4 S 30 W 22 1/2 - fo 4 N 87 W 37
- " # 6 fo 4 S 48 E 16 1/2 - fo 6 S 11 W 42
- " # 8 No 6 N 28 E 56
- " # 11 No 8 N 12 E 42 fo 8 N 57 W 70
- " # 13 No 10 N 5 W 25 1/2 No 10 S 62 E 18 1/2
- " # 16 fo 8 N 15 E 81 No 4 N 15 W 73

Sworn assistants  
 Chairmen  
 L E Goff  
 John Smith  
 Gilbert Hilliker  
 Michael Betheiser  
 Flagman  
 S S Hilliker Jr

Witness my hand at Sparta this 21st Jan ad 1901  
 Fred A Holden  
 Co Surveyor