


Survey & Subdivision of Section 18
Township 18 North Range 2 West

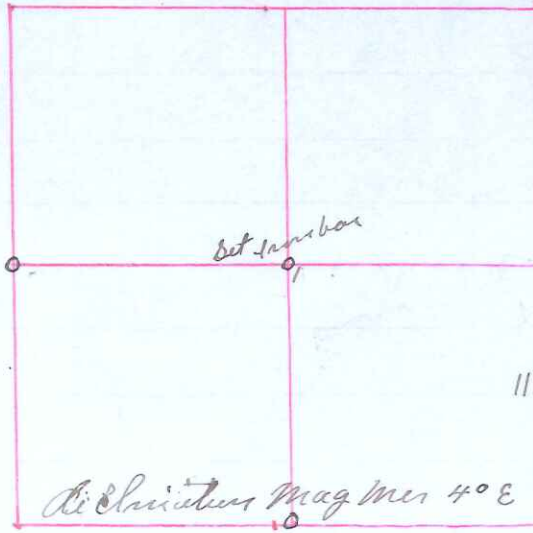

There being no trace of bearing there at SE corner of section 1 established same by chain East 80 chains 18 links from SE Cor Sec 17 as evidenced by one original bearing tree now standing continuing the same course 76 chains and 64 links across sec 18 according to govt survey then chaining south from 1/4 stake on west side of sections 40 chains to correct line locating 1/4 stake on south side 40 chains from SE Sec Cor - North West corner identified by trees made by survey of town ^{line} previously made locating NE corner sections by running north 160 chains to NE Cor sec 7 which I identified by stumps of original witnesses

Bearings as follows

- NW Sec Corner fo 5 N 44 W 110 Ba 0 3 S 56 1/2 W 143
- SE " " No 8 N 68 W 84 No 6 N 38 W 91
- E 1/4 " " fo 3 S 57 W 103 1/2 fo 4 S 35 W 133 1/2
- S 1/4 " " From bar at corner No 10 N 73 E 32 rods 30 links as per 5 N 15 E 20 rods 26
- W 1/4 " " From bar at corner
- Center 1/4 Section of "Pine" 5 S 14 E 62 of Pine 5 S 57 E 75-
- Post No 11 of Pine 10 S 31 W 38 1/2 fo 10 S 89 E 149

Sworn assistants

Michael Daly ?
Arthur Hall Chainman
George Harper Flagman
done Jan 23rd & 24th 1901
and Certificate issued
to A S Hall this
29th day of January ad 1901
Paul A Holder
Co Surveyor