


Survey & Subdivision of Section 13 Township 15 North Range

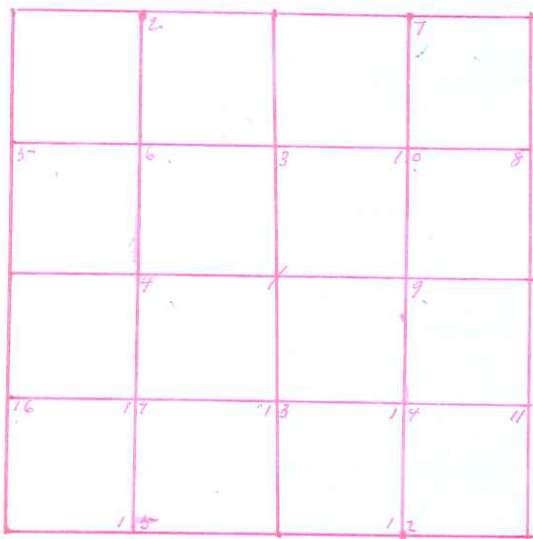

2^d West of 4th principal Meridian Made Feb 5th 6th 7th & 8th ad 1901 for Chas Ekstrom John Langfeldt Paul Buchatty Herman Haseley & Henry Mittag

NE Corner of Section identified by Original B trees Still Standing to wit:

Elm 14 S 50 W 38 Elm 12 N 33 E 10 Running South also set corner at corner 120 chains + 36 links located 1/4 Stake E Side Sec 24 original B trees shown 5 N 29 W 22

other trees gone so Established S E Corner of 13 at proportionate distance to wit 80 chains + 24 links from NE Corner thence West 79 chains 66 links identified S W Corner by Stumps of original B trees to wit Pine 36 S 8 W 48 Pine 20 N 19 E 24

Establishing N W Corner of Section 80 chains North of S W Corner and 79 chains + 20 links West of NE Corner Establishing all quarter posts at proportionate distances + centers of section at intersections of strait 1/4 lines Making Bearings as follows for S E corner Section

Elm 18 S 9 E 22 1/2 Maple 8 N 77 W 39

Survey Assistants

N 1/4 Post W 16 S 55 W 44 Maple 12 N 42 1/2 E 45

Chairmen

E " " Norway Pine 11 S 82 1/2 W 16 1/2 W Pine 12 N 5 W 25

Charles Ekstrom

S " " Elm 7 S 40 1/2 E 11 Elm 8 N 8 W 64

John Langfeldt

W " " W 9 N 48 E 38 Jo 4 S 76 E 22

Flagman

Center S W Pine 11 N 50 E 32 1/2 Elm 12 S 24 E 104 1/2

Paul Buchatty

at 3 W 10 N 9 W 43 Cherry 4 S 48 1/2 W 36

Assessors

" 4 W Pine 5 N 23 1/2 E 4 1/2 W Pine 5 N 89 1/2 W 7 1/2

Herman Haseley

" 5 W 5 S 69 1/2 E 34 Red O 7 S 14 E 99

Henry Mittag

" 6 W 9 S 15 W 75 W 16 N 15 1/2 E 3

declinations of Magnetic

" 7 W 16 N 47 E 50 W 5 N 82 1/2 W 46 1/2 Stone at Corner

Meridian 5° 30' East

" 8 Rednut 4 S 14 1/2 W 4 Red O 4 N 68 1/2 W 23

" 9 Red O 9 S 79 1/2 E 139 W Pine 4 N 57 E 165

" 10 W Pine 10 N 84 1/2 W 149 W Pine 10 S 56 1/2 W 163

" 12 Red O 12 N 58 W 28 Red O 4 N 26 E 42

" 13 Elm 12 N 22 W 61 Elm 16 S 64 W 84

" 15 Elm 14 S 27 W 36 Elm 10 N 50 E 60

" 16 Red O 3 S 25 W 11 W Pine 4 S 56 W 38

" 17 W 8 N 82 1/2 W 25 Elm 5 N 77 1/2 E 42

Recorded & Certificates issued this 9th day of Feb ad 1901

Paul A Holder

Co Surveyor