


RECORD OF SURVEY.

Plat of Section 36, Township 16 North, Range 11 W. East of Four
Principal Meridian, Scale 80 Chains to 6 $\frac{2}{3}$ inches.

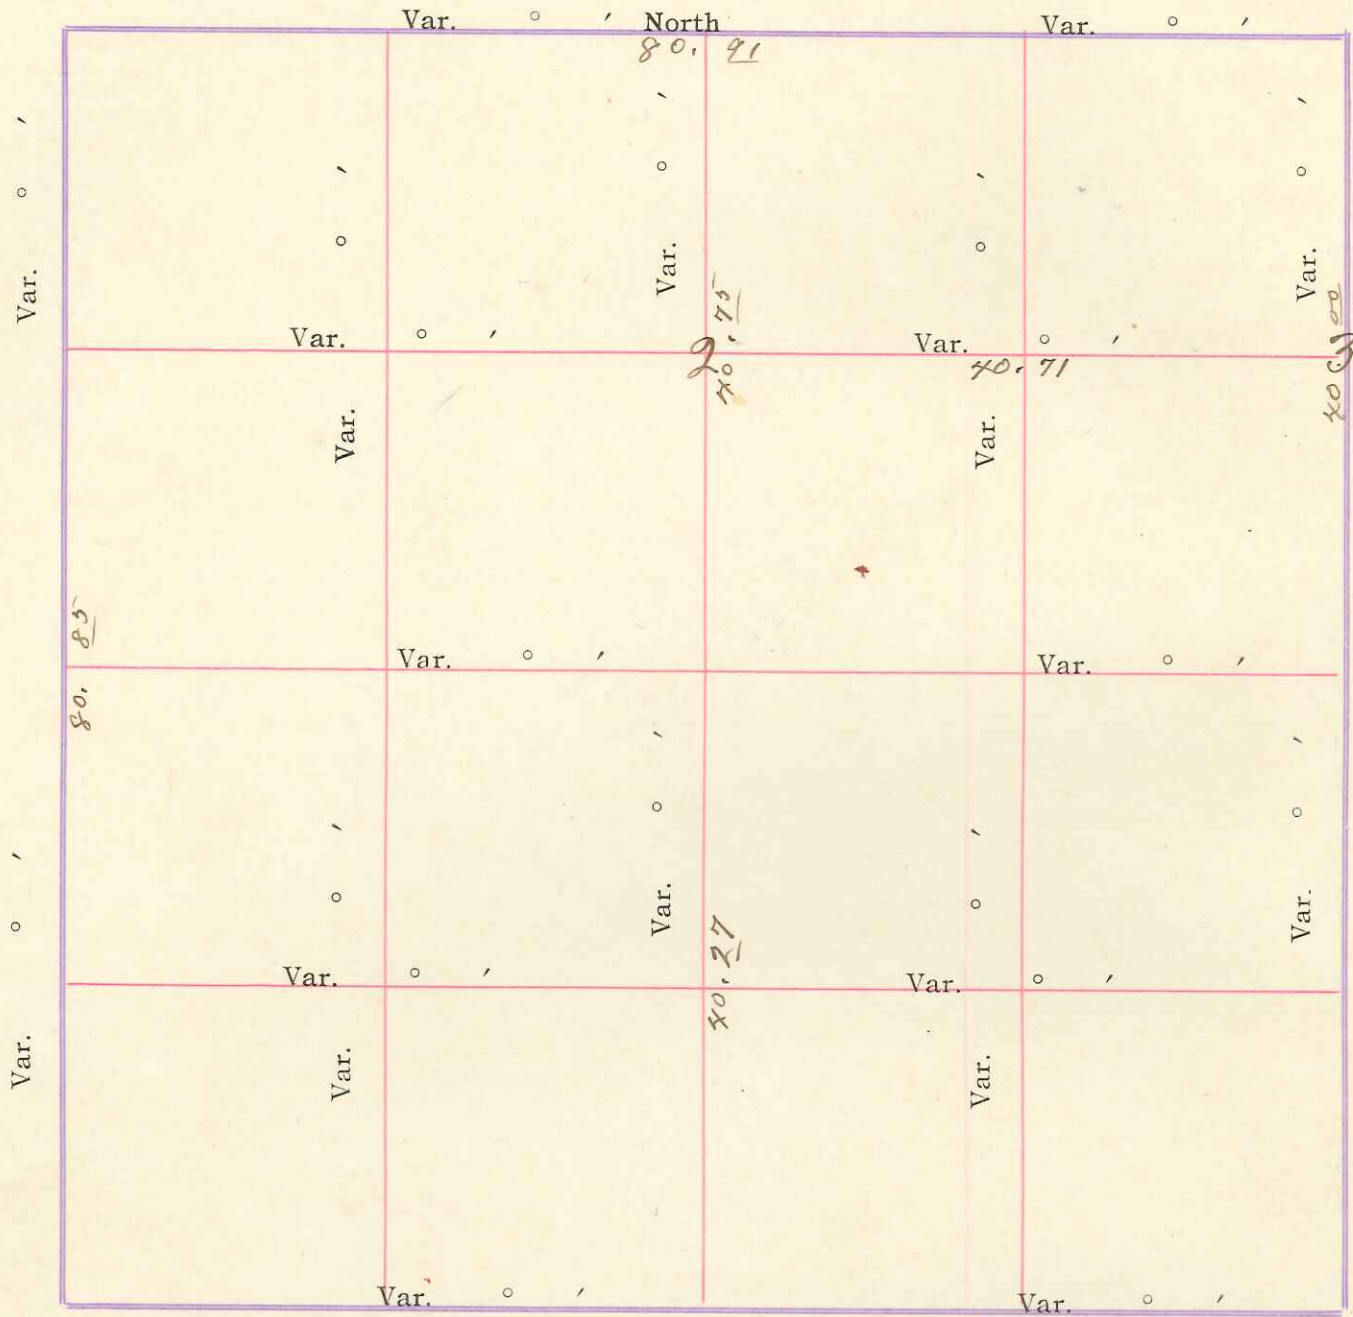

Surveyed May 10, 11, 12, 13 & 14 A. D. 1915, in accordance with
the State Laws and Instructions of the Commissioner of General Land Office.

Witness my hand this 14 day of May A. D. 1915
Henry F. Schroeder County
Surveyor

DESCRIPTION

of Section, Quarter Section and Quarter Quarter Section Corners

H. C. MILLER CO., MFG. STATIONERS, MILWAUKEE 104762

GOVERNMENT CORNERS		Bearing Trees	In Dia.	Courses they bear	Links Distant	Bearing Trees	In Dia.	Courses they bear	Links Distant
No.									
1.	N.W. Sec. Cor. Identified,	Found original Br. O. B.T. marks		BxO 30	set iron for corner.			original Bearing.	
2.	N. E. Sec. Cor. Identified,	Found " B.T. stump marks		W.O. 5	S 77° 56' 42"			new B.T.	
3.	S. E. Sec. Cor. Identified,								
4.	S. W. Sec. Cor. Identified,	Found stone set for corner		No. B.T.					
		Established equidistant and on line N.E. + N.W. corners		new					
5.	N. 1/4 Sec. Cor. Identified,			W.O. 5	S 98° W 19 1/2'	W.O. 6		N 73° E 6 1/2'	
6.	E. 1/4 Sec. Cor. Identified,	Found marked 1/4 sec post		No. B.T.					
				new					
7.	S. 1/4 Sec. Cor. Identified,	Found Original B.T. Stump marks		Hickory 4	S 21° W 15'	original W.O. 24		N 31° E 56'	
		Established equidistant and on line SW + NW corners				new B.T. near			
8.	W. 1/4 Sec. Cor. Identified,					set iron for corner in field.			
Subdivision Corners									
No.									
1.	Center 1/4 Sec. Cor.	Established at crossing of N+S and E+W 1/4 lines + set iron		W.O. 10	S 66 1/2° E 13 1/2'	W.O. 6		S 24 1/2° E 16'	
		Established equidistant and on line Center 1/4 cor + N 1/4 cor							
2.	N 1/8 on N+S 1/4 line	E 1/4 corner and NE corner.		W.O. 6	S 84 1/2° E 39'	new B.T.		new B.T.	
3.	N 1/8 " East Boundary	Established equidistant and on line		Hickory 8	N 5° W 37'	W.O. 6		N 59° E 34 1/2'	
4.									
5.									
Names of Sworn Assistants

CHAINMEN	FLAGMEN	AXEMEN
Oscar Olson Hans Holtonet	Harold Olson	

st of Four

Var. 20 3 00

Var.

lance with

A. D. 1915

Surveyor