


RECORD OF SURVEY.

Partial Plat of Section 29, Township 17 North, Range 2 ~~West~~ East of Four Principal Meridian, Scale 80 Chains to 6 $\frac{2}{3}$ inches.

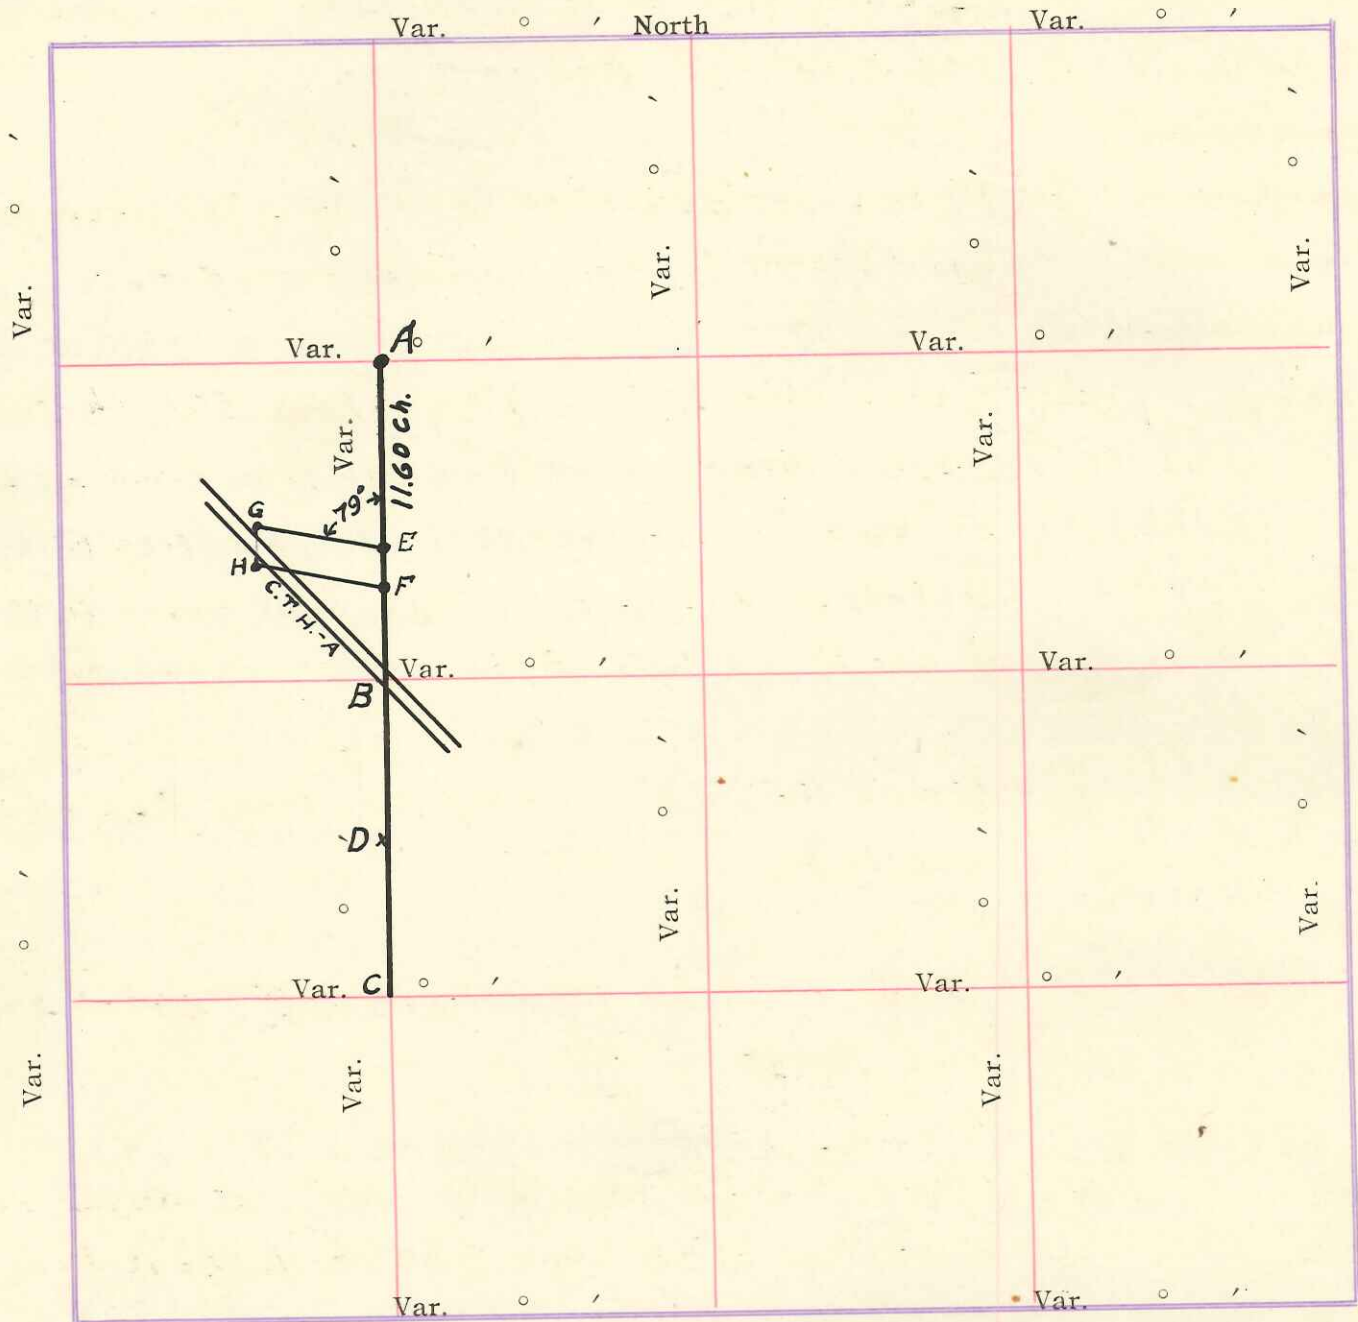

*Survey made by Tax Descriptions Project
Works Progress Administration - F. W. A.*

Surveyed October A. D. 1940, in accordance with the State Laws and Instructions of the Commissioner of General Land Office.

Witness my hand this 27 day of Nov. A. D. 1940

Ray W. Hurlburt
Surveyor.

DESCRIPTION

of Section, Quarter Section and Quarter Quarter Section Corners

H. C. MILLER CO., MFG. STATIONERS, MILWAUKEE 104702

GOVERNMENT CORNERS	Sec. 29 - T. 17 N. - R. 2 W.	Bearing Trees	In Dia.	Courses they bear	Links Distant	Bearing Trees	In Dia.	Courses they bear	Links Distant
No.									
1. N.W. Sec. Cor. Identified,	A - Found 1 1/4" Iron Pipe, up 20", as recorded by Holden in Vol. 1 P. 243								
2. N.E. Sec. Cor. Identified,									
3. S.E. Sec. Cor. Identified,	B - Did not find Holdens monument at this Cor. as Hiway has been relocated over Cor.								
4. S.W. Sec. Cor. Identified,									
5. N. 1/4 Sec. Cor. Identified,	C - Found Holdens Pipe at this Cor. had been pulled up and thrown to some distance from Cor.								
6. E. 1/4 Sec. Cor. Identified,									
7. S. 1/4 Sec. Cor. Identified,									
8. W. 1/4 Sec. Cor. Identified,									
Subdivision Corners									
No.									
1. Center 1/4 Sec. Cor.	D - Large Black Oak Tree about 30.00 ch. S. of A. Mr. J.A. Jones says Holdens line came up to E. side of this tree. Present fence is in line with E. side of tree at this point. Used this point to locate E and F on line A-D								
2.									
3.									
4.									
5.									
6.									
7.	E - Drove 1 1/4" x 33" Iron Pipe ^{up 8"} at fence Cor. on line A-D and 11.60 ch. S. of A.								
8.									
9.									
10.	F - Drove 1 1/4" x 33" Iron Pipe, up 8", 2.50 ch. S. of E on line A-D								
11.									
12.									
13.	G - Drove 3/4" x 29" Iron Bolt, up 8", at angle of 79° 00' W. of line E-A and 8.00 ch. distant from E.								
14.									
15.									
16.	H - Drove 3/4" x 29" Iron Bolt, up 8", 2.50 ch. S. of G on line parallel with line E-F.								
17.									

Names of Sworn Assistants

CHAINMEN	FLAGMEN	AXEMEN

of Four

ance with

D. 1940

Surveyor.