


DESCRIPTION

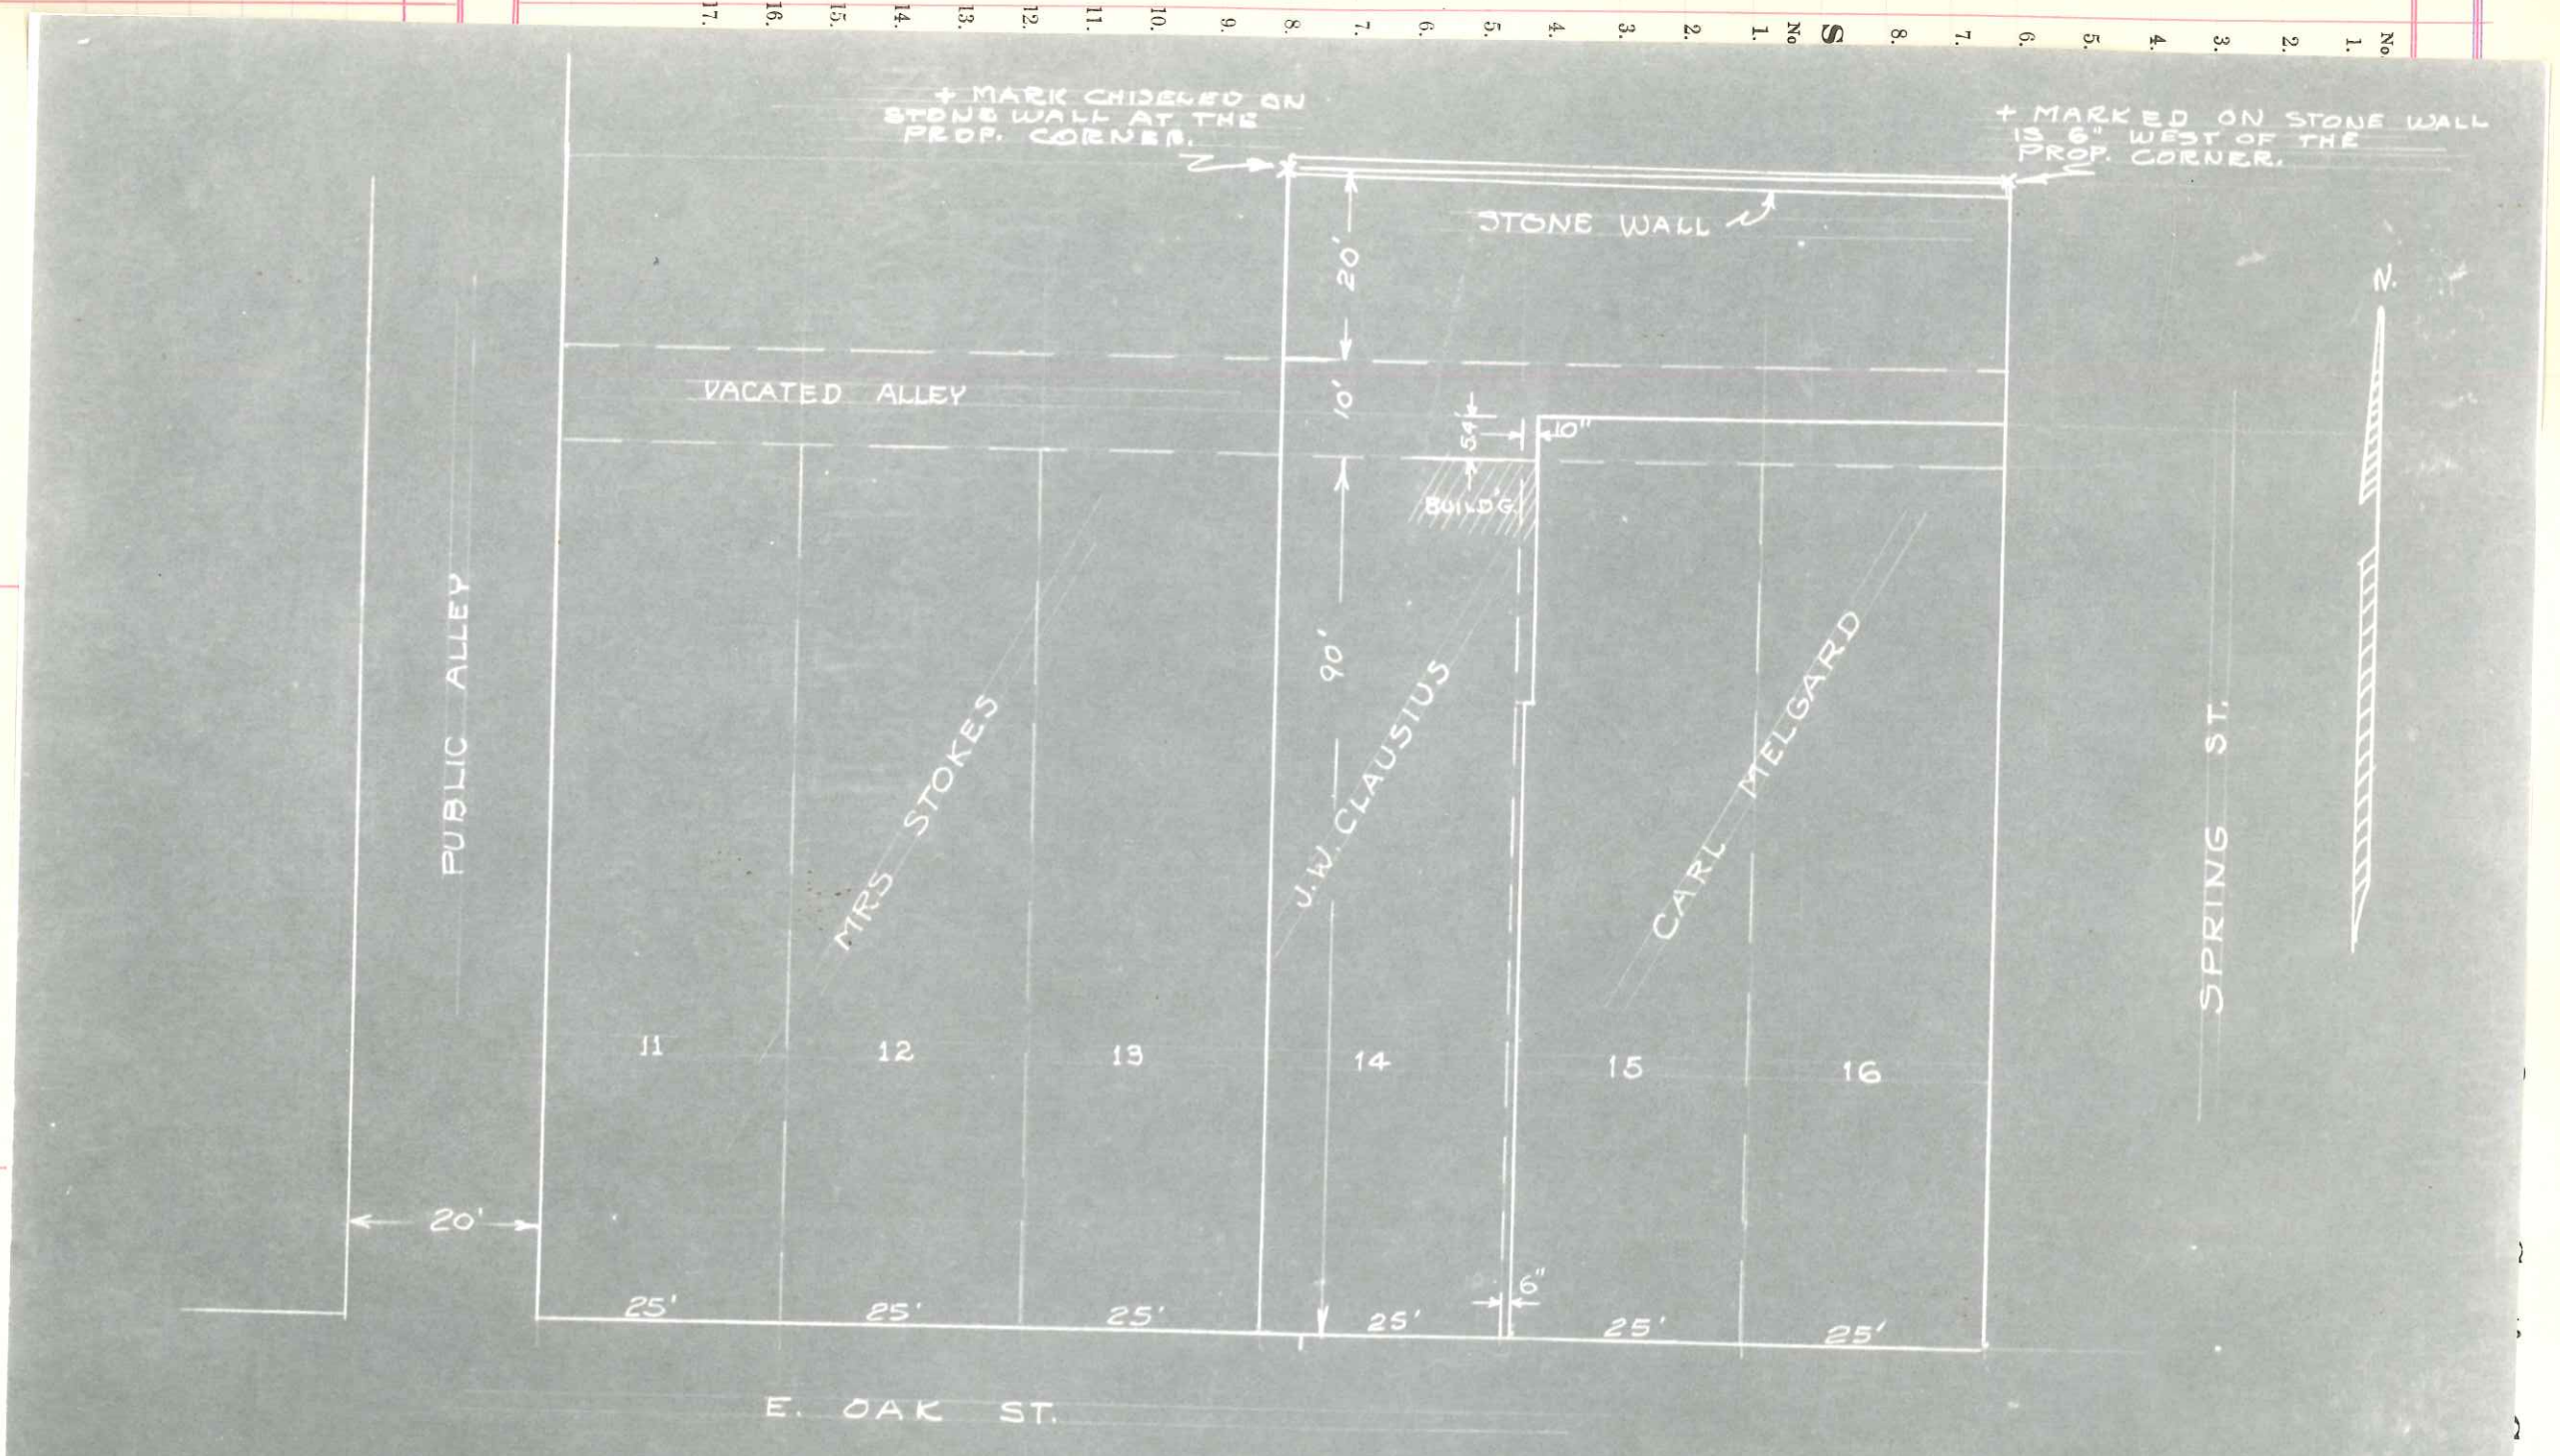

I HEREBY CERTIFY THAT TO THE BEST OF MY KNOWLEDGE & BELIEF THE ABOVE IS A TRUE REPRESENTATION OF LANDS OWNED BY J.W. CLAUSIUS IN CHAS. GOSS SUBD. TO THE CITY OF SPARTA MONROE CO. WISCONSIN -
 O.O. BERGMAN, SUR. 6-4-47

of Four

0.19

nce with

urveyor.