

CERTIFICATE

CERTIFIED LAND CORNER

No. 22

41501010020

I, Ronald D. Parish, do hereby certify that on the 26th day of March 1985, I found (evidence) (no evidence) of the S 1/2 corner of Section 1, T 15 N, R 1 E Fourth Principal Meridian, and I re-established said corner according to the Wisconsin Statutes as shown and described hereon.

Dated this 16th day of April 1985. Revised 12th day of Feb. 1987

Ronald D. Parish
Registered Land Surveyor
Title

History of corner establishment since Original Government Survey

No known history since the Original Government Survey


Description of corner evidence found:

No evidence of corner. Set corner on line between the SW Corner and the SE corner of the Section at equi-distance from each. This fits the occupied fence line East and West, there is no fence line North and South.



Description of corner and witness monuments, references and accessories used to perpetuate the original or re-established location of this corner:

Witnesses to corner location:

Ronald D. Parish
Charles Dade

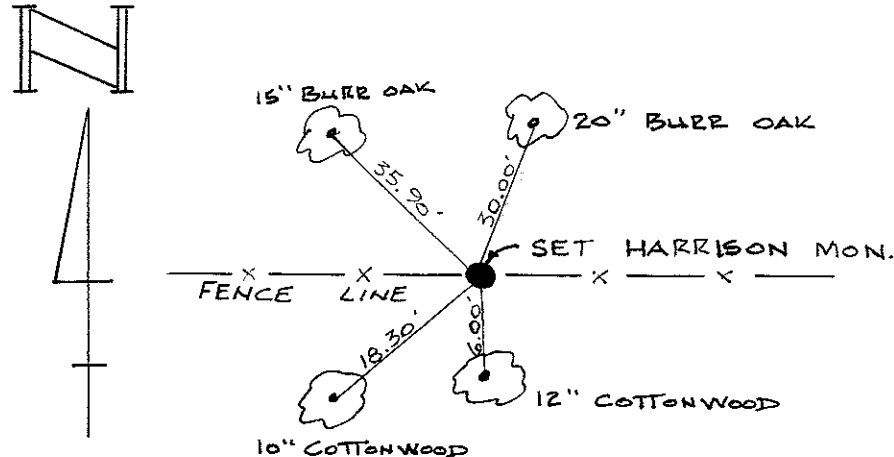

All trees double blazed with a spike in side of tree, meas. to spike

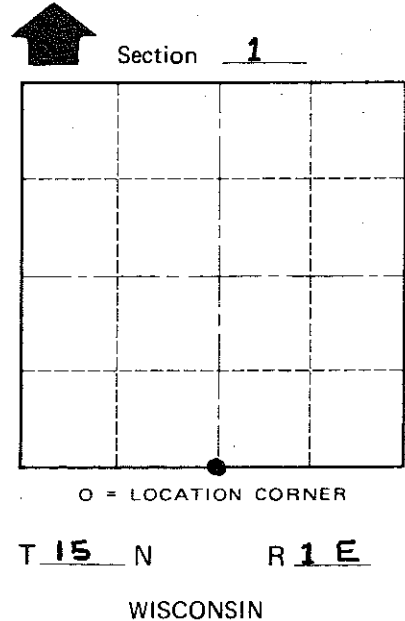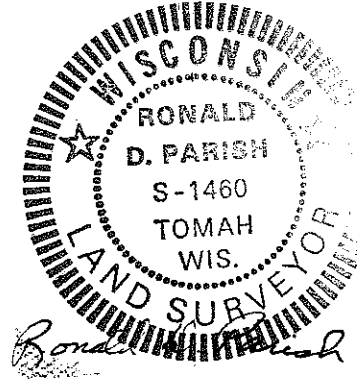

COUNTY SURVEYOR FORM NO. 1

SURVEY CONTROL ORDER

Horizontal _____
Vertical _____

WISCONSIN COORDINATE SYSTEM

Corner	East (X)	North (Y)	Elevation (Z)	Zone
Control Sta. Name				

City, Village or Town GLENDALE
County of MONROE