


# CERTIFIED LAND CORNER

I hereby certify that on the 29<sup>th</sup> Day of November 2007, I found (evidence) ~~(no evidence)~~ of the W1/4 corner of Section 12, T 15 N - R 1 E Fourth Principle Meridian and established said corner according to the Wisconsin Statutes.

SECTION 12

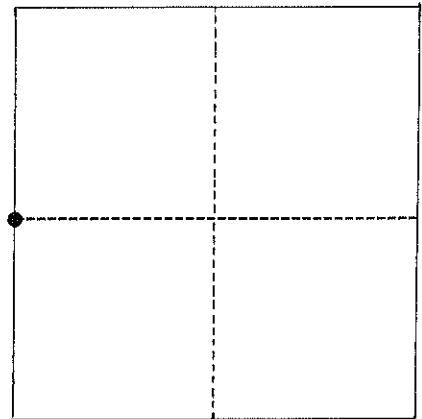


● = CORNER LOCATION  
T 15 N - R 1 E

Witnesses to corner location:

Zachariah P. Dechant

Gary L. Dechant

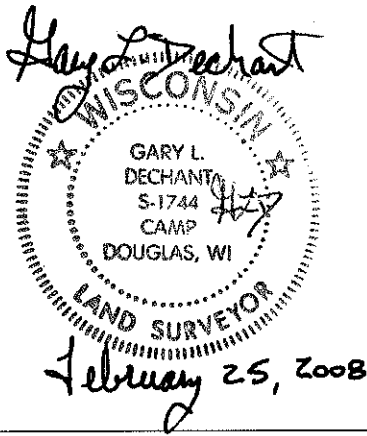

HISTORY OF CORNER:

DESCRIPTION OF CORNER EVIDENCE FOUND:

Found a 1-1/4" round iron bar at an existing fence corner.  
Accepted corner and replaced it with a TCP monument, set survey sign 1' east.

DESCRIPTION OF CORNER AND REFERENCE MARKERS:

Trees double blazed with 40d nail set.

○ = set 1"x18" iron pipe

