

41501152000

I, William C. Jung, do hereby certify that on the 5th day of May 1981 I found ~~(evidence)~~ (no evidence) of the East 1/4 corner of Section 15, T15 N, R 1 E Fourth Principal Meridian, and I re-established said corner according to the Wisconsin Statutes as shown and described hereon.

History of corner establishment since Original Government Survey

None recorded since the original government survey.

Description of corner evidence found:

The corner was set at a location so as to best fit the existing occupied evidence found along the East-West 1/4 line. There is no recorded survey to support this, but in my opinion, the South line of the NE1/4 was at one time surveyed and then fenced on that line. I set the corner so as to fit as best as possible the bulk of the evidence found along this line.

Dated this 25th day of Sept. 1981.

William C. Jung

William C. Jung, R.L.S. 1323
Title

Description of corner and witness monuments, references and accessories used to perpetuate the original or re-established location of this corner:


Witnesses to corner location:

Jung


Pietz

Dechant

Set a Harrison monument, down 12"+, in a farm trail and out in the middle of a field on top of an open hill. There were no ties near. However, I did place a 3/4" round iron bar, S86°W, 328.6 feet from the corner.

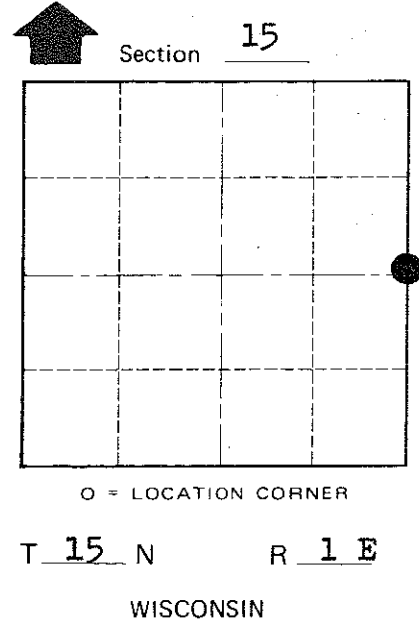

Approved: **HARLEY A. SIME**
MONROE CO. SURVEYOR

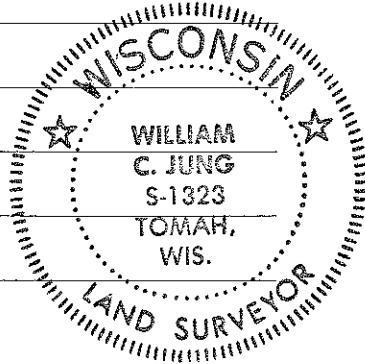

COUNTY SURVEYOR FORM NO. 1

SURVEY CONTROL ORDER

Horizontal _____
Vertical _____

WISCONSIN COORDINATE SYSTEM

Corner	East (X)	North (Y)	Elevation (Z)	Zone
Control Sta. Name				

City, Village or Town Glendale
County of Monroe
Wisconsin