

41501170020

I, William C. Jung, do hereby certify that on the 4th day of October 1982, I found ~~evidence~~ (no evidence) of the South 1/4 corner of Section 17, T 15 N, R 1 E Fourth Principal Meridian, and I re-established said corner according to the Wisconsin Statutes as shown and described hereon.

Dated this 26th day of Jan. 1983.

William C. Jung

Deputy County Surveyor

Title

History of corner establishment since Original Government Survey

Holden surveyed the South line of Section 17 in November of 1907 but does not show that he set anything at this corner. O.R. Dahl found this corner and used it in a survey in December of 1868. The 1915 County Plat Book shows one owner on both sides of the line going North, and two owners to the South, one on each

Description of corner evidence found: side of the line.

(See attached sheet, page 2)

Approved: **HARLEY A. SIME**
MONROE CO. SURVEYOR


COUNTY SURVEYOR FORM NO. 1

Description of corner and witness monuments, references and accessories used to perpetuate the original or re-established location of this corner:

Witnesses to corner location:



William C. Jung

Bryan H. Meyer

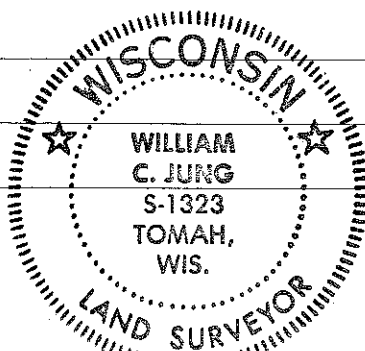

Set Harrison Marker
 27' N. of E, near
 base of N. rd. slope

3/4"x24" round I.B.
 survey point

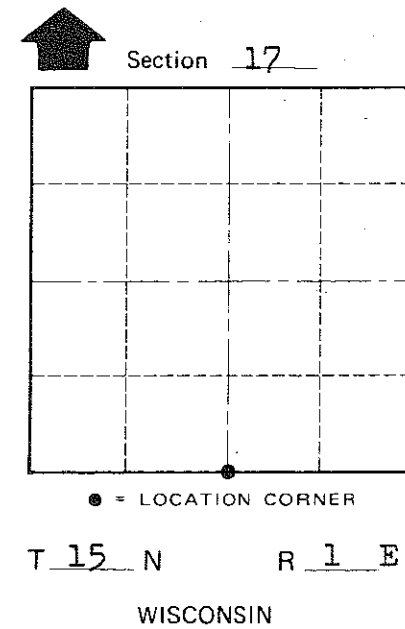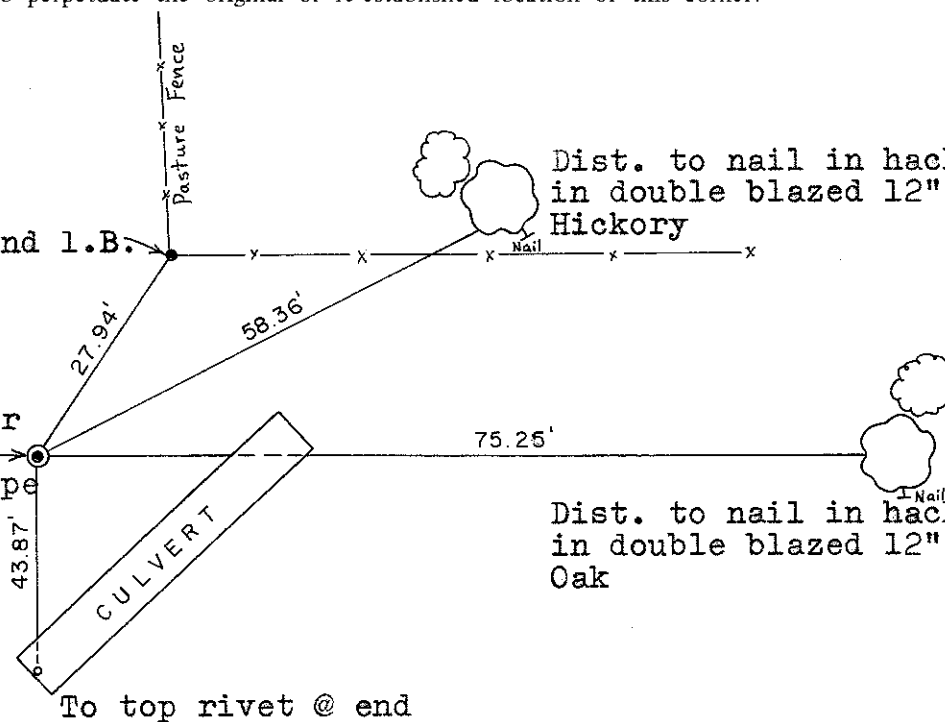

SURVEY CONTROL ORDER

Horizontal	_____
Vertical	_____

WISCONSIN COORDINATE SYSTEM

Corner	East (X)	North (Y)	Elevation (Z)	Zone
Control Sta. Name				

City, Village or Town of Glendale
 County of Monroe

1/4 Corner-Section 17-T15N-R1E

I did not accept the line fence to the North as it appears to be a pasture fence. The occupied brush line to the South falls about 27' East of my final corner and as such appears to be in error. In his 1907 survey Holden found the corner at the Southeast of Section 17. I had Meyer and Fox search for this corner on 7/23/82, but they found no evidence of the corner. One owner owns all the land around this corner. This was also the case in 1915. The corner has probably been lost for some time. I did find a fence corner at the S1/16SE of Section 17. Holden took this corner in his 1907 survey. I measured between the S1/16SE and SW Corners of Section 17. My distance matches Holden's within 5.36 feet. Also my angle between this section line and the South line of the SE1/4 of Section 18, matches the original notes within about 3.5 minutes. The occupied line to the South at the S1/16SW also fits my true corner within about 4'±. I feel that the fence corner at the S1/16SE of Section 17 is at Holden's location. As such, I set the 1/4 of Section 17 on line and proportionately between the S1/16SE and SW Corners.

