

CERTIFICATE

CERTIFIED LAND CORNER

No. 77

41501212000

I, Lawrence A. Feddersen, do hereby certify that on the 22 day of July 1981, I found (evidence) ~~XXXXXX~~ of the W¹/₄ corner of Section 22, T 15 N, R 1E Fourth Principal Meridian, and I re-established said corner according to the Wisconsin Statutes as shown and described hereon.

Dated this 30 day of Nov. 1981.

Lawrence A. Feddersen

Registered Land Surveyor
Title

History of corner establishment since Original Government Survey

In 1905 Holden set sleigh shoe.

Description of corner evidence found:



Found sleigh shoe set by Holden with help from adjacent land owners, Harold Wolfgram and Thomas Thomkins. Removed sleigh shoe and set Harrison in its place.

COUNTY SURVEYOR FORM NO. 1

Description of corner and witness monuments, references and accessories used to perpetuate the original or re-established location of this corner:

Witnesses to corner location:

- Lawrence Feddersen
- Thomas Mangene
- Timothy Fisher
- Harold Wolfgram
- Thomas Thomkins

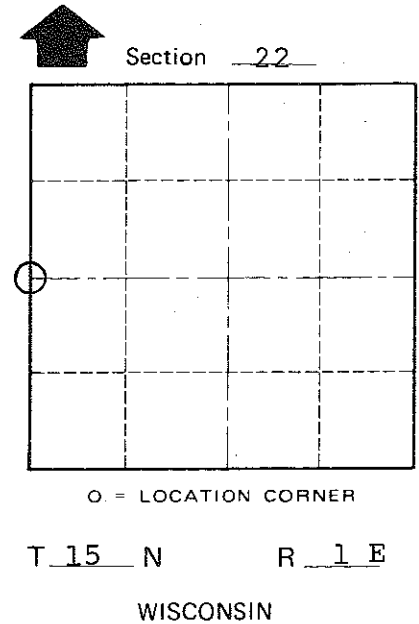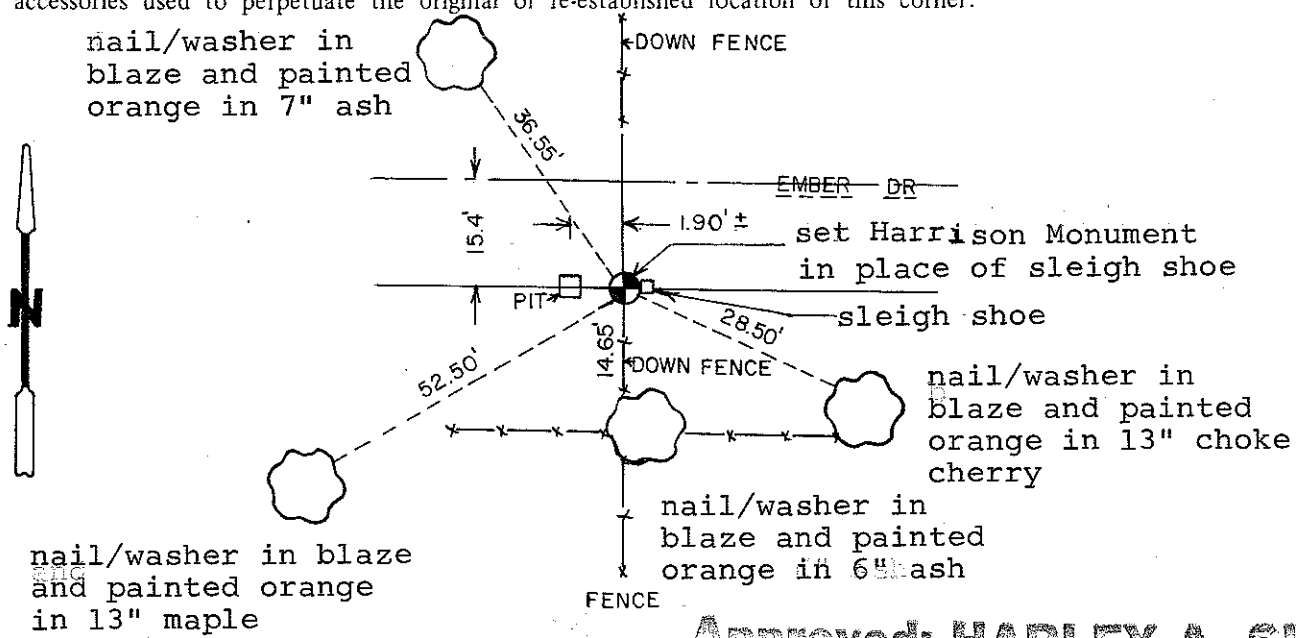

SURVEY CONTROL ORDER

Horizontal	
Vertical	

WISCONSIN COORDINATE SYSTEM

Corner	East (X)	North (Y)	Elevation (Z)	Zone
Control Sta. Name				

Approved: HARLEY A. SIME
MONROE CO. SURVEYOR

~~XXXXXX~~ Town of Glendale
County of Monroe

