

JUNEAU COUNTY SURVEY MONUMENT RECORD

CORNER NO. 94
SECTION 30
TOWN 15N.
RANGE 2E.

TYPE OF MONUMENT: 1-1/4" X 30" IRON ROD

JUNEAU COUNTY COORDINATES
NORTHING: 141,060.36
EASTING: 400,468.02

■ = CORNER MONUMENT RESTORED


BASIS FOR MONUMENT LOCATION
(USE REVERSE SIDE IF NECESSARY)

SHOW INFO SUCH AS: HISTORY OF CORNER, WITH REFERENCE TO VOLUME AND PAGE DATES, SURVEYOR, EXACT DESCRIPTION OF MONUMENT PLACED OR FOUND, IF LOCATION COMPUTED, BY TAPED OR EDM TRAVERSE; LANDOWNER REMARKS, ETC.

NO RECENT RECORD EVIDENCE FOUND. I DID FIND A VERY DISTINCT CHANGE IN FENCING, WHICH FIT VERY WELL AS COMPARED WITH A PROPORTIONED LOCATION. IRON POSTS ONLY TO THE NORTH AND ALTERNATING WOOD AND IRON POSTS TO THE SOUTH. ACCEPTED AS BEST AVAILABLE EVIDENCE.

LEGEND

- = 1-1/4" X 30" IRON ROD SET
 - = 3/4" X 24" IRON ROD SET
- AZIMUTHS ARE MAGNETIC

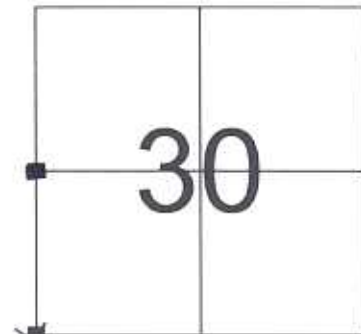

LOCATION



CERTIFIED CORRECT

Patrick J. Dederich
REGISTERED LAND SURVEYOR

DATE 9/20/2005

TIE SKETCH
(SHOW AT LEAST FOUR TIES)

