

CERTIFICATE

CERTIFIED LAND CORNER

No. 110

41501290020

I, Harley A. Sime, do hereby certify that on the 8th day of September 19 81, I found (evidence) (~~no evidence~~) of the N¹/₄ corner of Section 32, T 15 N, R 1 E Fourth Principal Meridian, and I re-established said corner according to the Wisconsin Statutes as shown and described hereon.

Dated this 21st day of Sept. 19 81

Harley A. Sime, R.L.S. 355

County Surveyor

Title

History of corner establishment since Original Government Survey
 Fred Holden set a stone(+) here in May of 1904.
 D. Marten set a 3/4" iron bar here in June of 1974.

Description of corner evidence found:

Found Marten's 3/4" iron bar and replaced it with a Harrison Monument.

Description of corner and witness monuments, references and accessories used to perpetuate the original or re-established location of this corner:



Witnesses to corner location:

G. Dechant

B. Meyer

C. Pietz

COUNTY SURVEYOR FORM NO. 1

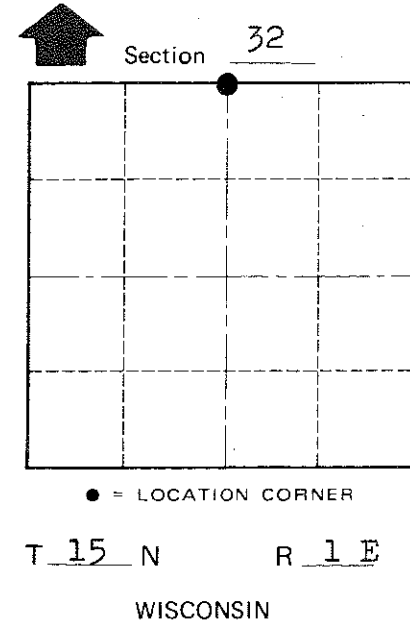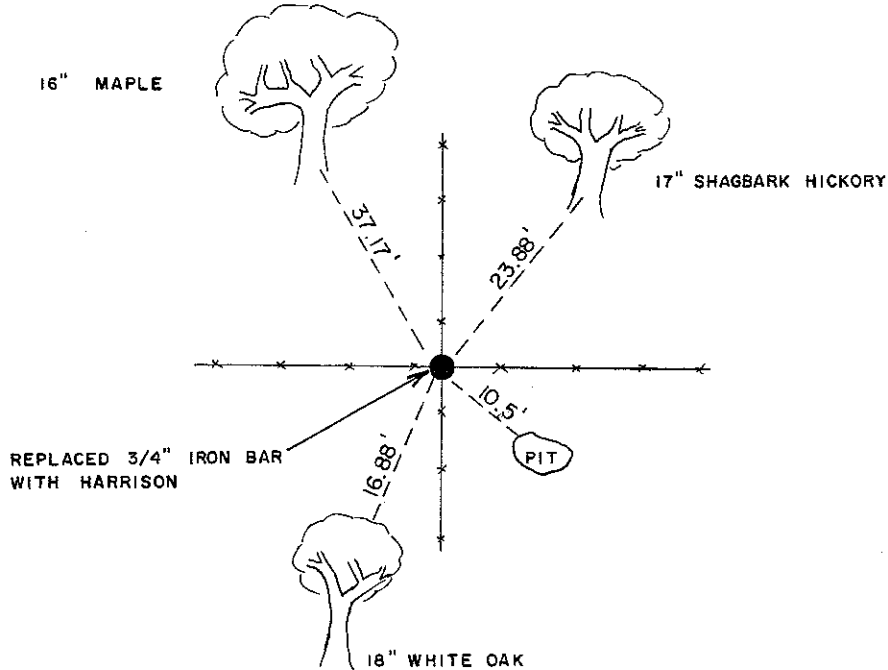

Approved: HARLEY A. SIME
MONROE CO. SURVEYOR

SURVEY CONTROL ORDER

Horizontal	_____
Vertical	_____

WISCONSIN COORDINATE SYSTEM

Corner	East (X)	North (Y)	Elevation (Z)	Zone
Control Sta. Name				

(Trees double blazed with nails set)

~~City, Village~~ Town Glendale
 County of Monroe