

21501030020

I, Harley A. Sime, do hereby certify that on the 10th day of November 1980, I found (evidence) ~~(no evidence)~~ of the North 1/4 corner of Section 10, T 15 N, R 1 W Fourth Principal Meridian, and I re-established said corner according to the Wisconsin Statutes as shown and described hereon.

History of corner establishment since Original Government Survey

Davy was here in November of 1926, and set a Ford axle.

Description of corner evidence found:

Found Davy's Ford axle in hay field, down 10", 68' North and 6' East of occupied fence corner. Also found Davy's White Oak bearing tree.

Dated this 10th day of Nov. 1980.

Harley A. Sime - R.L.S. 355

County Surveyor-Monroe Co. Wisconsin
Title

COUNTY SURVEYOR FORM NO. 1



Description of corner and witness monuments, references and accessories used to perpetuate the original or re-established location of this corner:

Witnesses to corner location:

Bryan Meyer

Scott Sowers

Approved: **HARLEY A. SIME**
MONROE CO. SURVEYOR

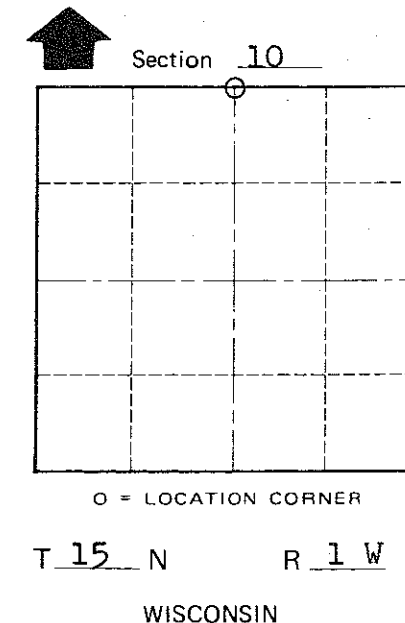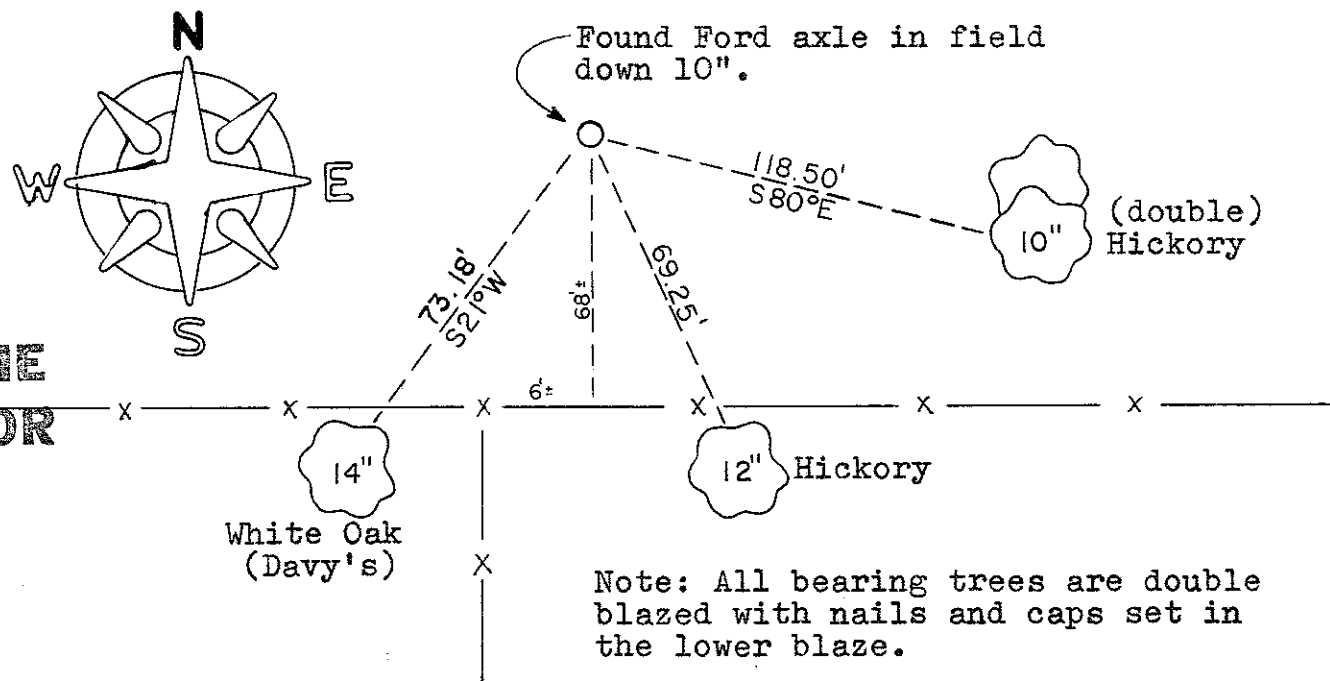

Note: All bearing trees are double blazed with nails and caps set in the lower blaze.

SURVEY CONTROL ORDER	
Horizontal	_____
Vertical	_____

WISCONSIN COORDINATE SYSTEM

Corner	East (X)	North (Y)	Elevation (Z)	Zone
Control Sta. Name				

~~City, Village or Town~~ of Wellington
County of Monroe
Wisconsin