

21501040000

I, Harley A. Sime, do hereby certify that on the 11th day of November 1980, I found (evidence) (~~was evidence~~) of the Northwest corner of Section 10, T15 N, R 1 W Fourth Principal Meridian, and I re-established said corner according to the Wisconsin Statutes as shown and described hereon.

Dated this 11th day of Nov. 1980.

Harley A. Sime

County Surveyor-Monroe Co. Wisc.
Title

History of corner establishment since Original Government Survey

Frank Davy was here in November of 1926, and set an iron shaft.

Description of corner evidence found:

Found Davy's iron shaft at the occupied fence corner. Also found bearing tree. Replaced shaft with Harrison.



COUNTY SURVEYOR FORM NO. 1

Description of corner and witness monuments, references and accessories used to perpetuate the original or re-established location of this corner:

Witnesses to corner location:

Bryan Meyer
Scott Sowers

Approved: HARLEY A. SIME
MONROE CO. SURVEYOR

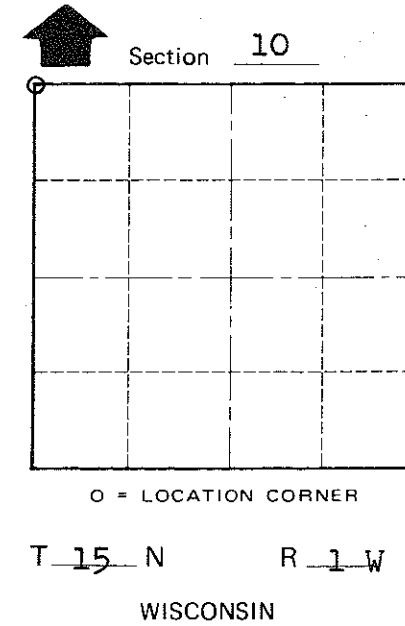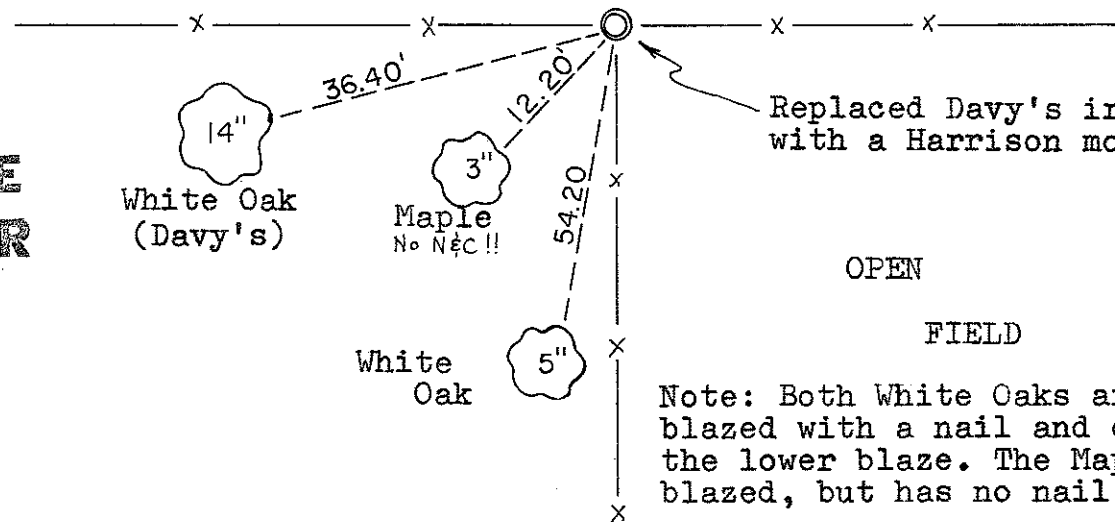

Note: Both White Oaks are double blazed with a nail and cap set in the lower blaze. The Maple is double blazed, but has no nail and cap.

SURVEY CONTROL ORDER

Horizontal	_____
Vertical	_____

WISCONSIN COORDINATE SYSTEM

Corner	East (X)	North (Y)	Elevation (Z)	Zone
Control Sta. Name				

~~City, Village or Town~~ of Wellington
County of Monroe
Wisconsin