

47

**U.S. PUBLIC LAND CORNER
MAINTENANCE**


Corner ID : SE Sec.9, T15N-R1W

21501090000

<u>DATE</u>	<u>CREW</u>	<u>MONUMENT TYPE</u> -----
September 9, 2014	Zachariah P.Dechant Gary L. Dechant	Found Harrison 7' east of centerline CTH "Z", in line with fence to east and west.

References:

	<u>Bearing</u>	<u>Distance</u>
1) Set 3/4"x24" square iron bar, down 12" in field	N61E	39.34'
2) Set 3/4"x24" square iron bar, down 12" in field	S86E	36.71'
3) Set 3/4"x24" square iron bar, down 6" in r/w fence 10' south of corner post	S76W	43.52'
4) Set 3/4"x24" square iron bar, down 10" north side of field entrance	N64W	52.37'

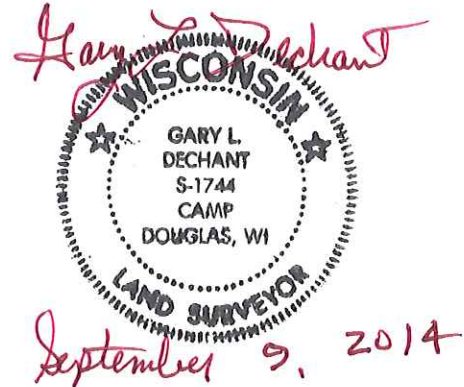

I, Harley A. Sime, do hereby certify that on the 11th day of November 1980, I found ~~evidence (no evidence)~~ of the Southwest corner of Section 10, T 15 N, R 1 W Fourth Principal Meridian, and I re-established said corner according to the Wisconsin Statutes as shown and described hereon.

Dated this 11th day of Nov. 1980.

Approved: HARLEY A. SIME
MONROE CO. SURVEYOR

History of corner establishment since Original Government Survey

A.S. Ingalls found the corner in March of 1873.
Frank Davy was here in November of 1926.
He set a 1" iron pipe.

Description of corner evidence found:

Lined down fences to the North and East and set a survey point at the intersection. This point fit Davy's distances to the creeks North and East very well. Following computation, I accepted this point as the corner. I could not find Davy's monuments. Set a Harrison marker. This location fits the evidence found in the SW1/4 very well.

**See Reverse Side
For Maintenance**



COUNTY SURVEYOR FORM NO. 1

Description of corner and witness monuments, references and accessories used to perpetuate the original or re-established location of this corner:

Witnesses to corner location:

Bryan Meyer

Scott Sowers

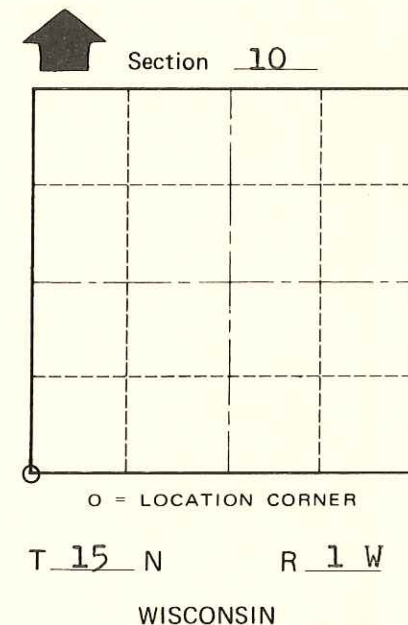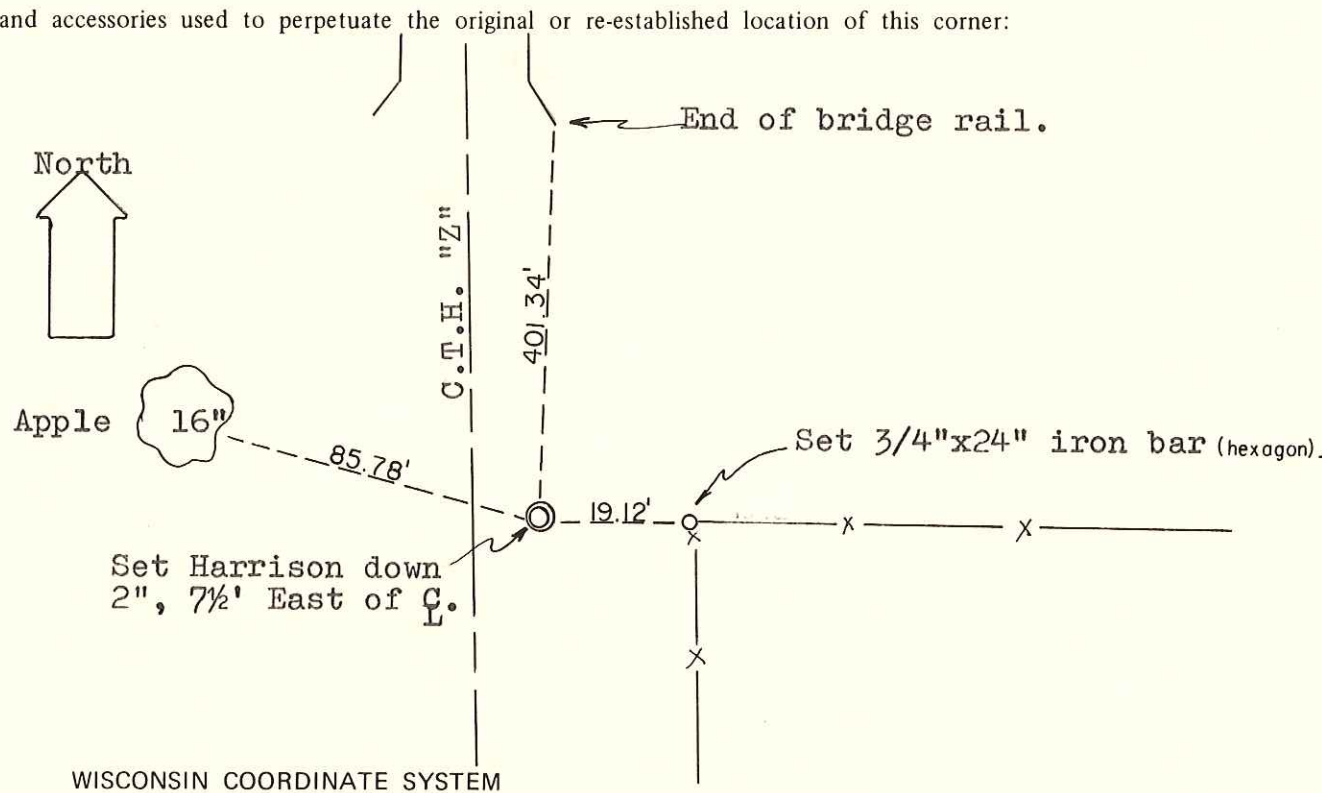

SURVEY CONTROL ORDER

Horizontal	_____
Vertical	_____

Corner	East (X)	North (Y)	Elevation (Z)	Zone
Control Sta. Name				

City, Village or Town of Wellington

County of Monroe
Wisconsin