

21501090020

MONROE COUNTY

Survey Monument Record

TYPE OF MONUMENT: 1/4" x 24" IRON PIPE SET

STATE PLANE COORDINATES: N _____ E _____

ELEVATION - M.S.L. DATUM: _____

THETA ANGLE: _____


FIELD BOOK: _____ PAGE _____

CORNER NO. 48

SECTION 16

TOWN 15N

RANGE R1W WELLINGTON

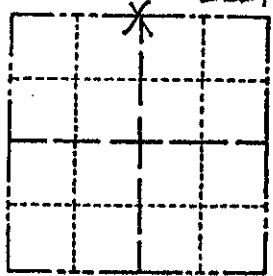

LOCATION (Indicated by 'X')

SEAL:

BASIS FOR MONUMENT LOCATION

(Use reverse side if necessary)

Show info such as: History of corner, with reference to Vol. and pg. dates, surveyor; exact description of monument replaced; if location computed, by taped or EDM traverse; landowner remarks, etc.

The existing split in E-W fence is the best evidence of corner location. Landowner Dave Pasch to the north verified this location.



CERTIFIED CORRECT:


Patrick A. Carroll

Registered Land Surveyor

DATE: 5/22/06

TIE SKETCH

(Show at least four ties)

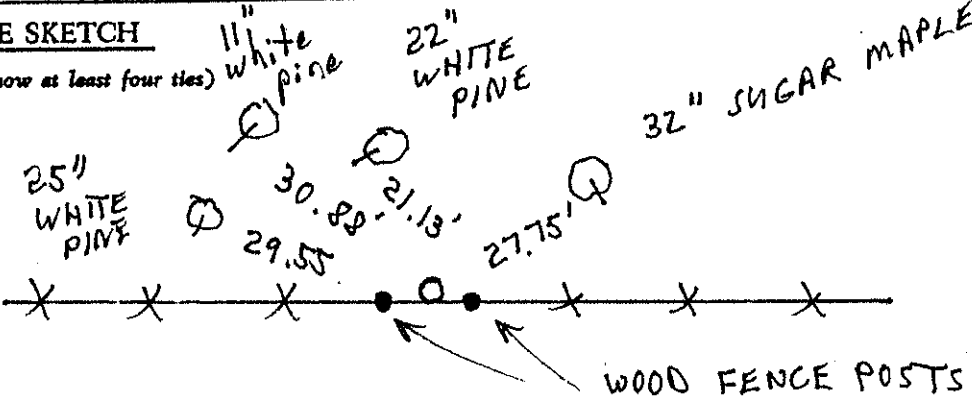

TIES ARE 6" SPIKES.

1/4" x 24" IRON PIPE SET

