

21501102000

I, Harley A. Sime, do hereby certify that on the 9th day of October 1980 I found (evidence) ~~(no evidence)~~ of the East 1/4 corner of Section 10, T 15 N, R 1 W Fourth Principal Meridian, and I re-established said corner according to the Wisconsin Statutes as shown and described hereon.

Dated this 9th day of Oct. 1980.

Harley A Sime - R.L.S. 355

County Surveyor-Monroe Co. Wisconsin
Title

History of corner establishment since Original Government Survey
 Fred Holden was here in November of 1901 and set an iron bar.
 Davy was here in November of 1926, and found Holdens bar and replaced it with a Ford axle.

Description of corner evidence found:

Found Ford axle set by Davy at occupied fence corner, up 1". Also found bearing tree stumps.

COUNTY SURVEYOR FORM NO. 1


Description of corner and witness monuments, references and accessories used to perpetuate the original or re-established location of this corner:

Witnesses to corner location:


Bryan Meyer

Chuck Dade

**Approved: HARLEY A. SIME
 MONROE CO. SURVEYOR**

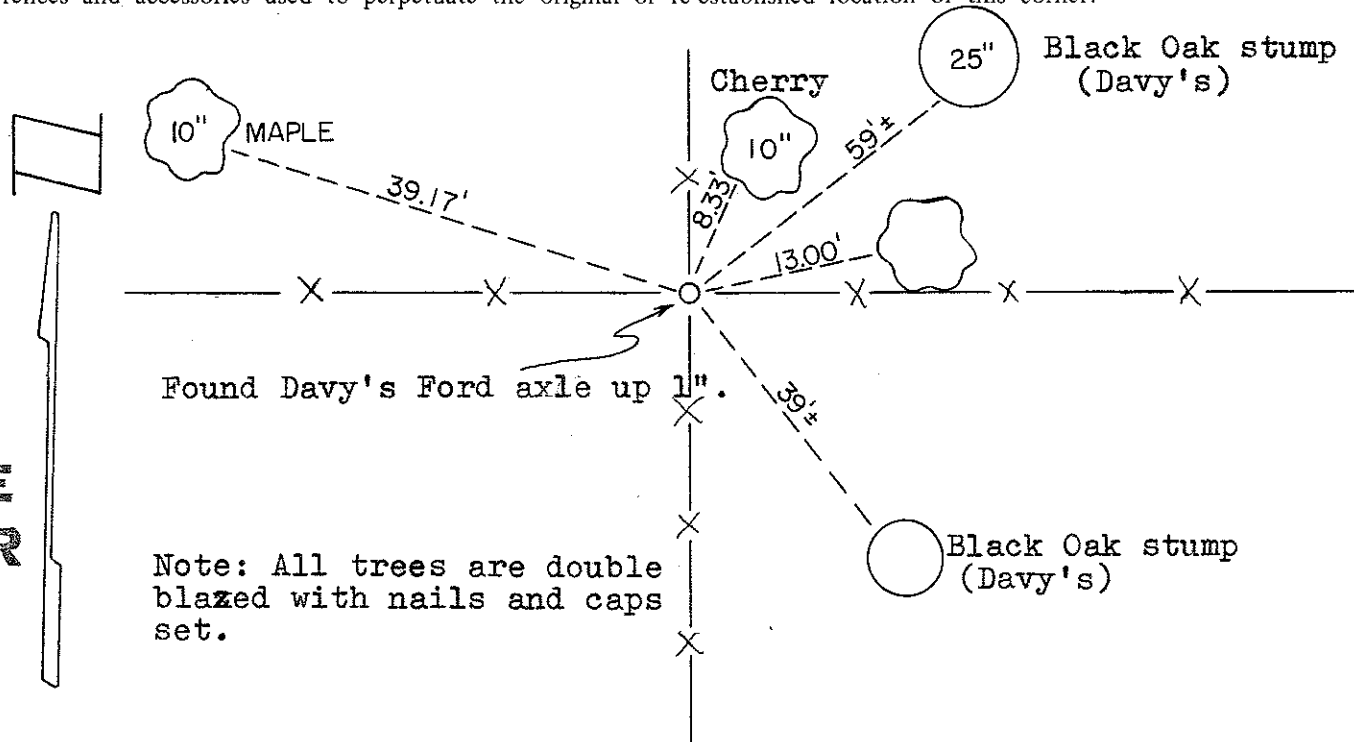

Note: All trees are double blazed with nails and caps set.

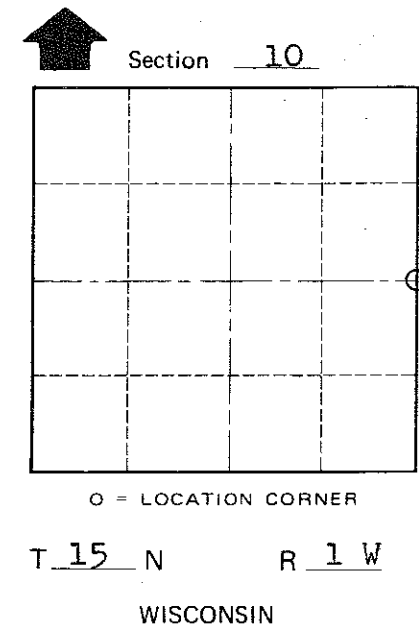

SURVEY CONTROL ORDER

Horizontal	_____
Vertical	_____

WISCONSIN COORDINATE SYSTEM

Corner	East (X)	North (Y)	Elevation (Z)	Zone
Control Sta. Name				

~~City, Village or Town~~ of Wellington
 County of Monroe
Wisconsin